


1993 SOUTHEASTERN MT MAINTENANCE PROJECT

DSL - AMRB No. 93-M04

FINAL REPORT

Several Counties in Southeastern, Montana

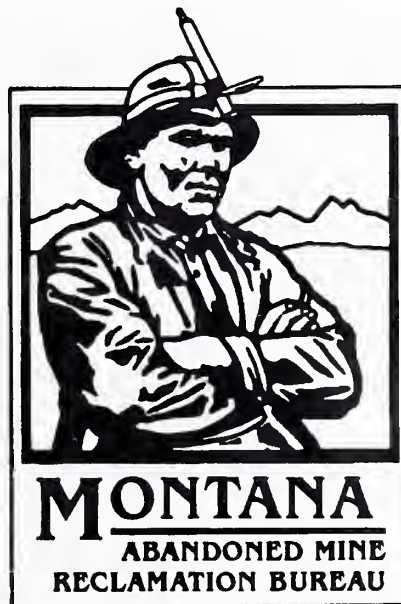

December 30th, 1993

SPECTRUM ENGINEERING

Billings, Montana

STATE DOCUMENTS COLLECTION

MAR 16 1994

MONTANA STATE LIBRARY
1515 E. 6th AVE.
HELENA, MONTANA 59620

RECEIVED
JAN 03 1994
STATE LANDS

FINAL REPORT

1993 SOUTHEASTERN MT MAINTENANCE PROJECT

DSL - AMRB No. 93-M04

Sites Located in Southeastern Montana

Bryan
Coal Creek
Crow Rock
Leo/Anderson
Klein Revegetation
McElroy
Dandy West Upper

Lehigh (added site)

December 30th, 1994

Spectrum Engineering
1413 4th Avenue North
Billings, MT 59101

PLEASE RETURN

TABLE OF CONTENTS

| | | |
|-------|--|----|
| 1. | INTRODUCTION | 1 |
| 1.1 | Project Description | 1 |
| 1.1.1 | Location and Access | 1 |
| 1.1.2 | Land Ownership | 4 |
| 1.1.3 | History | 6 |
| 1.2 | Project Objectives/Site Problems | 6 |
| 1.2.1 | Bryan | 6 |
| 1.2.2 | Coal Creek | 6 |
| 1.2.3 | Crow Rock | 6 |
| 1.2.4 | Sonenberg-Roth | 7 |
| 1.2.5 | Leo/Anderson | 7 |
| 1.2.6 | Klein Revegetation | 7 |
| 1.2.7 | McElroy | 8 |
| 1.2.8 | Dandy West Upper | 8 |
| 1.2.9 | Lehigh | 8 |
| 2. | RESPONSIBLE PARTIES | 9 |
| 2.1 | Contractor | 9 |
| 2.2 | Reclamation and Engineering Plan | 9 |
| 2.3 | Quality Control Inspection | 9 |
| 2.4 | AMRB Coordination | 9 |
| 3. | CHRONOLOGICAL LISTING OF EVENTS | 9 |
| 3.1 | Pre-Bid Conference | 9 |
| 3.2 | Bid Date | 10 |
| 3.3 | Three Lowest Bids | 10 |
| 3.4 | Contract Award/Notice of Award/Notice to Proceed | 10 |
| 3.5 | Construction Start-up | 10 |
| 3.6 | Change Orders | 10 |
| 3.7 | Work Stoppages | 11 |
| 3.8 | Requests for Payment | 11 |
| 3.9 | Substantial Completion | 11 |
| 3.10 | Final Completion and Approval | 11 |
| 3.11 | Final Payment | 11 |
| 4. | CONSTRUCTION | 11 |
| 4.1 | Description of Project Plan | 11 |
| 4.2 | Major Equipment List | 12 |
| 4.3 | Contractor Employees | 12 |
| 4.4 | Construction Activities | 12 |
| 4.5 | Quantities Used | 14 |
| 5. | PROJECT COSTS | 14 |
| 5.1 | Pay Request | 14 |
| 5.2 | Cost per Site | 15 |
| 5.3 | Total Project Cost | 15 |



Digitized by the Internet Archive
in 2014

<https://archive.org/details/1993southeastern1993spec>

| | | |
|-----|---|----|
| 6. | PROJECT SUMMARY | 15 |
| 6.1 | Summary of Project | 15 |
| 6.2 | Site Condition after Completion | 15 |
| 6.3 | Maintenance or Follow-up | 16 |
| 6.4 | Bid Package (Construction) Drawings | 16 |
| 6.5 | As-Built Drawings | 16 |
| 7. | COMMENTS/SUGGESTIONS | 16 |
| 8. | PHOTOGRAPHS/SLIDES | 17 |
| 8.1 | Listing | 17 |
| 8.2 | Photo Location Map | 17 |
| 8.3 | Photos/Slides | 17 |

1993 SOUTHEASTERN MT MAINTENANCE PROJECT

1. INTRODUCTION

1.1 Project Description

The 1993 Southeastern MT Maintenance Project consists of 8 project sites located in southeastern Montana from the Wyoming state line to the south to Jordan to the north. These sites are found in Powder River, Custer, Garfield, Musselshell and Carbon Counties. All of these sites were previously reclaimed under the abandoned mine program and had failed in one way or another. One of the original eight sites was dropped for lack of landowner consent and one new maintenance site was added in Judith Basin County called Lehigh. The need for this project was to protect human health and safety caused by subsidence and dangerous openings.

The work consisted of salvaging and replacing topsoil; closing mine adits and shafts; backfilling subsidence; regrading erosional areas; neutralizing coal slack; and revegetating disturbed areas. The Contractor was also required to secure a MPDES Storm Water Discharge Permit to cover all sites.

1.1.1 Location and Access

Bryan Site.

The Bryan Site is located in the SW $\frac{1}{4}$ NE $\frac{1}{4}$ Section 18, T3S, R46E in Powder River County. The latitude is 45° 34.50' and the longitude is 106° 05.70'. The site is found on the USGS 7½ minute quadrangle named Coleman Draw.

The site is situated about half-way between Ashland and Broadus along Highway 212. Access is by travelling ½ mile north via a dirt road off of paved State Highway 212 eight miles east of Ashland.

Coal Creek Site.

The Coal Creek Site is located in the NE $\frac{1}{4}$ NW $\frac{1}{4}$ Section 3, T3S, R45E in Powder River County. The latitude is 45° 36.30' and the longitude is 106° 09.66'. The site is found on the USGS 7½ minute quadrangle named Willow Crossing.

The site is situated 8 miles by road northeast of Ashland. Access is by taking the Otter Creek road off U.S. Highway 212 for about 1½ miles. At this point, turn north and continue on a dirt road to the site.

Crow Rock Site.

The Crow Rock Site is located in the SW $\frac{1}{4}$ Section 17, T12N, R45E in Custer County. The latitude is 46° 47.66' and the longitude is 106° 05.72'. The site is found on the USGS 7½ minute quadrangle named Crow Rock SE.

1993 SOUTHEASTERN MT MAINTENANCE PROJECT

It is situated about 33 miles northwest of Miles City. Access is by proceeding north out of Miles City on Highway 59 from Miles City to Jordan. Follow this paved road 31 miles and then turn right onto a gravel road (3 miles north of Angela and 3 miles south of Rock Springs). Follow the gravel road 6½ miles until you intersect the Crow Rock Road (running north-south). Turn left (north) and proceed 1 mile. Leave the main road and proceed on a dirt road across the field 2/3 of a mile to the northwest until you reach the site.

Sonenberg-Roth.

The Sonenberg-Roth Site is located in the SE¼ Section 15, T18N, R37E in Garfield County. The latitude is 47° 19.0' and the longitude is 106° 59.2'. The site is found on the USGS 7½ quadrangle named Jordan.

It is situated approximately 4 miles south of Jordan. Access is by proceeding southwest from Jordan on Highway 200 for 3.4 miles until reaching mile post 209. Turn right (north) on a dirt road and follow this road for 1.1 miles. The access trail turns west (left) at this point. Follow this road for approximately 1 mile to the site.

Leo/Anderson Site.

The Leo/Anderson Site is located in the NE¼NE¼ Section 26, T19N, R38E in Garfield County. The latitude is 47° 23.0' and the longitude is 106° 50.0'. The site is found on the USGS 7½ minute quadrangle named Jordan NE.

It is situated approximately 4 miles northeast of Jordan. Access is by proceeding east from Jordan on Highway 200 for 5¼ miles. Turn left (north) on Haxby Road and proceed for 5½ miles. Turn left (west) onto a dirt road and follow for 3½ miles to the site.

Klein Revegetation Site.

The Klein Revegetation Site is located in the S½NW¼ and N½SW¼ Section 36, T8N, R25E in Musselshell County. The latitude is 46° 24.2' and the longitude is 108° 32.5'. The site is found on the USGS 7½ minute quadrangle named Roundup.

It is situated approximately 46 miles north of Billings. Access is by proceeding north 46 miles from Billings Highway 87 to the town of Klein and turning right (east) onto a dirt road to the site. The coal slack piles are immediately adjacent to the highway.

McElroy Site.

The McElroy Site is located in the NW¼NW¼ Section 36, T4S, R22E in Carbon County. The latitude is 45° 27.0' and the longitude is 108° 57.5'. The site is found on the USGS 7½ minute quadrangle named Fromberg.

1993 SOUTHEASTERN MT MAINTENANCE PROJECT

It is situated approximately 3 miles south of Joliet. Access is by proceeding south from Joliet on the Joliet-Fromberg Road for approximately 2 miles and then turning right (southwest) on a dirt road for ½ mile to the site.

Dandy West Upper Site.

The Dandy West Upper Site is located in the NE¼NE¼ Section 8, T9S, R27E in Carbon County. The latitude is 45° 04.3' and the longitude is 108° 26.1'. The site is found on the USGS 7½ minute quadrangle named Red Pryor Mountain.

It is situated approximately 13 miles east of the abandoned town site of Warren (21 miles south of Bridger). The best access is heading 50 miles south via Highway 310 from Laurel to Warren, Montana. At Warren, turn left (east) and proceed east 2 miles on a paved road to the BLM Helt Road (a gravel access road). Then proceed on Helt Road 10 miles. At this point the road forks to the north and to the south. Turn left (north) and travel 1 mile to the site. This road is in poor condition and requires a four wheel drive vehicle to access the site.

The reader is referred to the Site and Vicinity Maps shown on the Site Plan sheets for further description of the access to the sites. No 8 ½ x 11 inch site access maps were prepared for these sites.

Lehigh Site.

The Lehigh Site is located in the SE¼ Section 21, T15N, R12E in Judith Basin County. The latitude is 47° 02.7' and the longitude is 110° 12.3'. The site is found on the USGS 7½ minute quadrangle named Windham.

It is situated approximately 3 miles southwest of Windham. Access is by exiting Highway 87 running from Great Falls to Lewistown and proceeding southwest from Windham for approximately 3 miles on the Sage Creek gravel road. The concrete coal tipple at Lehigh is adjacent to the site with the subsidence hole adjacent to the red barn on the right hand side of the road just beyond the coal tipple.

1993 SOUTHEASTERN MT MAINTENANCE PROJECT

1.1.2 Land Ownership

The land ownership is shown in the following table from Section I of the bid package.

| <u>SITE NAME</u> | <u>LOCATION</u> | <u>LANDOWNER/CONTACT</u> |
|--|---|--|
| <u>POWDER RIVER COUNTY</u> | | |
| Bryan | SW $\frac{1}{4}$ NE $\frac{1}{4}$ Section 18, T3S, R46E | Custer National Forest Ashland Ranger District Bill Ott, District Ranger P.O. Box 168 Ashland, MT 59003 406-784-2344 |
| Coal Creek | NE $\frac{1}{4}$ NW $\frac{1}{4}$ Section 3, T3S, R45E | Great Northern Properties Limited Partnership 1101 North 27th St., Suite 201 Billings, MT 59101 Attn: Steven K. Shirley Vice-President and Resident Manager 406-248-4885 |
| <u>CUSTER COUNTY</u> | | |
| Crow Rock | SW $\frac{1}{4}$ Section 17, T12N, R45E | Great Northern Properties Limited Partnership 1101 North 27th St., Suite 201 Billings, MT 59101 Attn: Steven K. Shirley Vice-President and Resident Manager 406-248-4885 |
| <u>GARFIELD COUNTY</u> | | |
| Sonenberg-Roth (Landowner consent denied-site dropped) | SE $\frac{1}{4}$ Section 15, T18N, R37E | Coleman & Virginia Murnion P.O. Box 13 Jordan, MT 59337 406-557-2251 406-429-7351 (Winnitt) |
| Leo/Anderson | NE $\frac{1}{4}$ NE $\frac{1}{4}$ Section 26, T19N, R38E | Ted & Jack Binion (Landowners) Binion's Horseshoe Casino Las Vegas, NV 89101 702-382-1600 |

1993 SOUTHEASTERN MT MAINTENANCE PROJECT

Leo/Anderson (cont.)

James P. Lucas (Contact)
Attorney-at-Law
P.O. Box 728
Miles City, MT 59301
406-232-4070

MUSSELSHELL COUNTY

Klein Revegetation

S $\frac{1}{2}$ NW $\frac{1}{4}$ and N $\frac{1}{2}$ SW $\frac{1}{4}$
Section 36, T8N, R25E

Alan Churchill
1219 2nd East
Box 987
Roundup, MT 59072
406-323-1180 or 323-2403

A portion of S $\frac{1}{2}$
Section 36, T8N, R25E

Larry Zimmerman
P.O. Box 1329
Fort Myers, Florida 33902
813-939-0955

CARBON COUNTY

McElroy

NW $\frac{1}{4}$ NW $\frac{1}{4}$
Section 36, T4S, R22E

LANDOWNER
State of Montana
(All of Sec. 36)
C/O Dept of State Lands
Jeff Hagener, Chief
Surface Management Bureau
Land Administration Division
1625 11th Avenue
Helena, MT 59620
406-444-2074

ACCESS OWNER AND
LESSEE
Lessee for All of Section 36
and Owner of Access Route in
Section 25
Mrs. Mary David
P.O. Box 215
Joliet, MT 59041
406-962-3433

Dandy West Upper

NE $\frac{1}{4}$ NE $\frac{1}{4}$
Section 8, T9S, R27E

LANDOWNER
Bureau of Land Management
Ken Hanify
Billings Resource Area
810 E. Main
Billings, MT 59105
406-657-6262

1993 SOUTHEASTERN MT MAINTENANCE PROJECT

Dandy West Upper (cont.)

MINERAL CLAIMANT
James J. Stoick
1600 Avenue E
Billings, MT 59102
406-252-1438

1.1.3 History

The history (if any existed) on each of these projects is found with the original bid packages and final reports for these projects. No history is repeated herein.

1.2 Project Objectives/Site Problems

This project was needed to protect health and safety caused by subsidence holes and dangerous openings which have reopened since the original AMRB work at each site was completed. The site problems are described below:

1.2.1 Bryan

The work is to close one adit which has reopened and reseed the prior vegetated area which has failed.

The Contractor will strip and stockpile 1 foot of cover soil from the borrow area. Backfill the 5'x7' adit opening with borrow material. Fill can be obtained from the adjacent dirt bank. Place 1 foot of stockpiled topsoil over the borrow area and the backfilled adit. All disturbed areas will be revegetated. In addition, the coal slack area previously neutralized and seeded will be revegetated.

1.2.2 Coal Creek

The goal is to fix some erosional problems and then revegetate.

The Contractor will regrade the area containing the seven erosional channels (two 60' x ½' x ½' and five 35' x ½' x ½'). No additional fill will be necessary. The regraded area will then be revegetated. Four straw bale dikes (2 bales per regraded channel) will be placed at the down slope end of each of the regraded erosional channels.

1.2.3 Crow Rock

The goal is to fix some erosional problems, excavate and backfill two subsidence holes and then revegetate.

The Contractor will regrade the area containing the four erosional channels (four 40' x ½' x ½'). No additional fill will be necessary. Strip and stockpile 1 foot of cover soil from the borrow area. The two subsidence holes (8" dia. x 17' deep and 6" x 16" x 15'

1993 SOUTHEASTERN MT MAINTENANCE PROJECT

deep) will be excavated down a minimum of five feet. These holes will then be backfilled with 2 cubic yards of borrow material. The borrow area is adjacent to the subsidence holes. Place 1 foot of stockpiled cover soil over the backfilled subsidence holes. Two straw bale dikes (2 bales per regraded channel) will be placed at the down slope end of each of the regraded erosional channels.

1.2.4 Sonenberg-Roth

The goal is to fix some erosional problems, excavate and backfill one subsidence hole and then revegetate.

The Contractor will regrade the area containing the erosional channel (60' x 1' W x 2' deep). No additional fill will be necessary. Strip and stockpile 1 foot of cover soil from the borrow area. Backfill the subsidence hole (8' x 5' x 7' deep) with 6 cubic yards of borrow material. The borrow area is adjacent to the subsidence hole. Place 1 foot of stockpiled cover soil over the backfilled subsidence hole and the borrow area. Revegetate the regraded area, the borrow area, and the backfilled subsidence hole. A straw bale dike (4 straw bales) will be placed at the down slope end of the regraded erosional channel.

1.2.5 Leo/Anderson

The goal is to backfill one subsidence hole and then revegetate.

The Contractor will strip and stockpile 1 foot of cover soil from the borrow area. Backfill the subsidence hole (10' x 10' x 7' D) with 15 cubic yards of borrow material. The borrow area is adjacent to the subsidence hole. Place 1 foot of stockpiled cover soil over the backfilled subsidence hole and the borrow area. Revegetate the borrow area and the backfilled subsidence hole.

1.2.6 Klein Revegetation

The Contractor will excavate a disposal pit (100' x 120') a depth of 2 feet for coal slack disposal. The topsoil (900 cubic yards) will be stockpiled adjacent to the pit. The slopes on two of the coal slack piles (number 2 and 3) will be reduced to approximately 3H:1V. The slack material (500 CY pile 2 and 200 CY for pile 3) will be buried in the disposal pit. Then neutralize all four coal slack piles, 5 small areas and the disposal pit with 11.2 tons lime (0.80 acres using 14 tons per acre). Respread the topsoil over the disposal pit and all neutralized areas to a depth of 8 inches. Grade to the disposal pit flat. Revegetate the neutralized area and all other disturbed areas (0.8 acres).

1993 SOUTHEASTERN MT MAINTENANCE PROJECT

1.2.7 McElroy

The goal is to excavate one adit opening and seal that adit with borrow material and then revegetate.

The Contractor will strip and stockpile 1 foot of cover soil from the borrow area. The borrow area is adjacent to the adit. Excavate the adit opening to allow backfilling and stockpile this material (estimated at 1½ cubic yards). Backfill the adit with borrow material and stockpiled material from the excavation of the adit opening. This backfilling will extent to 10 feet into the adit from the adit opening (estimated at 5 cubic yards). Place 1 foot of stockpiled cover soil over the backfilled adit and the borrow area. Revegetate the borrow area and the backfilled adit.

1.2.8 Dandy West Upper

The goal is to excavate two runoff diversion ditches, backfill the shaft, remove and replace the steel grate on the shaft, rebuild the slope adjacent to the shaft, and revegetate.

The Contractor will remove and salvage the failed steel grate covering the shaft. Excavate a runoff diversion ditch on the northern edge and one ditch on the southern edge of the slope to be rebuilt. These ditches will be 2 foot deep and 4 foot wide at the top and approximately 100 feet in combined length. Backfill shaft (12' x 18' x 26' D) with 170 cubic yards of material from Waste Dump #4. Replace the salvaged steel grate over backfilled shaft. Rebuild the slope west of and adjacent to the shaft using 175 cubic yards of material from Waste Dump #4. Broadcast seed and fertilize the rebuilt slope and borrow area. Place 18 straw bales on the toe of the rebuilt slope.

1.2.9 Lehigh

The goal is to backfill one large subsidence hole, install a new shaft cover, and revegetate.

The Contractor will excavate a drainage ditch out the side of the subsidence hole to facilitate water drainage. Then backfill the subsidence hole (32' x 40' x 23' deep) with 1,100 cubic yards of material from the borrow area. Strip and replace the topsoil (289 cubic yards) from the borrow area. Fabricate a new steel shaft cover (37" x 37"), paint with galvanizing paint, and provide 4 padlocks to lock down the cover. Seed, fertilize and mulch the backfilled subsidence hole and trench (0.12 acres). The borrow area will remain unvegetated since it is in a cultivated field.

1993 SOUTHEASTERN MT MAINTENANCE PROJECT

2. RESPONSIBLE PARTIES

2.1 Contractor

The successful low bidder was Baxter Construction. Their address is shown below:

Baxter Construction
4014 Hardin Road
Billings, Montana 59101
Phone: 406/259-6404
MT Contractor's License: 4884 A

2.2 Reclamation and Engineering Plan

Spectrum Engineering was assigned the responsibility of preparing the reclamation and engineering specifications prior to contractor selection. Plans conforming to the general requirements were formulated in the field to meet specific conditions.

Spectrum's address is shown below:

Spectrum Engineering
1413 4th Avenue North
Billings, Montana 59101
Phone: 406/259-2412

2.3 Quality Control Inspection

Spectrum Engineering performed the quality control inspection. The project engineer was Bill Maehl and the construction inspectors were Bob Seader and John Deeney.

2.4 AMRB Coordination

The AMRB Project Manager was Joel Chavez, Montana Department of State Lands, Abandoned Mine Reclamation Bureau.

3. CHRONOLOGICAL LISTING OF EVENTS

3.1 Pre-Bid Conference

The pre-bid conference was held on August 10th, 1993 at the Klein Revegetation project site at the town of Klein south of Roundup.

1993 SOUTHEASTERN MT MAINTENANCE PROJECT

3.2 Bid Date

The bid opening date was August 20th, 1993.

3.3 Three Lowest Bids

There were 3 bidders on this project with bids ranging from \$20,403.00 to \$28,312.00. The engineer's estimate was \$26,285.00. The bid tabulations have been included in ATTACHMENT 1. The three bidders are listed below.

| | | |
|---------------------|---------------------|-------------------|
| Baxter Construction | Hallett Reclamation | Pine Street |
| Billings, Montana | Livingston, Montana | Glendive, Montana |
| \$ 20,403.00 | \$ 27,237.00 | \$ 28,312.00 |

3.4 Contract Award/Notice of Award/Notice to Proceed

The contract was awarded to the low bidder (Baxter Construction) after receiving all of their bonds, stormwater permit, and other required paper-work. The Agreement was dated September 15th, 1993.

The Notice to Proceed was issued September 7th with a work start date of September 20th, 1993. Baxter Construction performed all of the work themselves. The work started September 20th at the Coal Creek site and was completed on October 26th at the Klein site. The additional Lehigh site was completed on December 14 and 16th, 1993. They used 37 calendar days of the 45 allowed calendar days to complete the work. They work 21 days of actual time to complete all of the sites including Lehigh.

3.5 Construction Start-up

The Contractor started mobilizing his equipment to the Coal Creek site on September 20th, 1993.

3.6 Change Orders

There was one change order written for this project. A copy of this change order is included in this report as ATTACHMENT 2. The change order was for final quantity adjustments, deleting the Sonenberg-Roth site, adding the Lehigh site, and adding the Larry Zimmerman area at the Klein site. The change order added a total of \$8,492.13 to the contract price with \$6,501 of that being the Lehigh site.

1993 SOUTHEASTERN MT MAINTENANCE PROJECT

3.7 Work Stoppages

There were two work shut-downs during the project. One occurred when snow prevented completion of the Klein site. The second work shut-down came after Klein was completed until the landowner consent could be secured for the Lehigh site.

3.8 Requests for Payment

There were two payment requests on this project. Pay Request 1 was for the period from job start through 10/19/1993. The amount completed for this pay request was \$20,403.00. The second pay request was from 10/20/93 through job completion.

3.9 Substantial Completion

The date of Substantial Completion was October 26th, 1993.

3.10 Final Completion and Approval

The AMRB field inspection date was October 5th, 1993. The Final Completion date is one year from the Substantial Completion date or October 26th, 1994.

3.11 Final Payment

Final payment will be made to the Contractor in January, 1994. Copies of the two payment requests have been included in ATTACHMENT 3.

4. CONSTRUCTION

4.1 Description of Project Plan

The objective of the proposed work is to perform maintenance work on previously reclaimed AMRB coal projects. The work at each site varied from minor to more complex and time-consuming. None of these sites presented any construction difficulties. Several of the sites had further subsided from when the AMRB/engineer field visit occurred and when construction started. Reclamation plans were developed on-site for these extras.

1993 SOUTHEASTERN MT MAINTENANCE PROJECT

4.2 Major Equipment List

| <u>Type</u> | <u>Make/Model</u> | <u>Size/Horsepower</u> | <u>No. on Job</u> |
|----------------------|-------------------|------------------------|-------------------|
| Track loader | John Deere 755 | 2¼ yd - 152 hp | 1 |
| Track loader-backhoe | Case 580D | 7/8 yd - 55 cy | 1 |
| Scraper | Terex TS-14 | 14 yd - 288 hp | 1 |
| Scraper | Michigan 110-11 | 11 yd | 1 |
| Dump truck | Ford | 6 yd | 1 |
| Motor grader | Cat 12E | | 1 |

4.3 Contractor Employees

The number of contractor employees on the job was 2 counting the Contractor himself.

4.4 Construction Activities

Baxter Construction moved their equipment to the Coal Creek site on September 20th and started work. Three new subsidence holes had opened up (6' x 12' x 6' deep, 8' x 8' x 6' deep and 12' x 12' x 6' deep). These holes were backfilled and seven erosional channels were filled. Straw bale dikes were installed on erosional channels and all disturbance revegetated.

Mobilized to the Bryan site on September 21st, backfilled the adit opening (using 15 cy rather than the 3 cy estimated). Worked up the bare spots and revegetated.

Moved to Crow Rock on 9/21/93 and started work. Filled the erosional channels and installed straw bales. The two very small subsidence holes (8-inch diameter) had joined and formed one very large hole (12' x 20' x 8' deep). This hole was backfilled and all disturbed areas revegetated.

Moved to Leo-Anderson on 9/22/93 and completed this site. Excavated out the subsidence hole and backfilled. All disturbed areas revegetated.

The McElroy site was done on September 23rd. The adit was larger than anticipated when opened up and required additional fill (closer to 20 cy additional above the estimated 5 cy). All disturbed areas were revegetated.

Dandy West Upper was completed on 9/24 and 9/27-28/93. This air shaft connects with the underground workings and had enlarged allowing the grate to collapse into the opening. This shaft required a total of 562.5 cubic yards to fill (170 original estimate). Only half of the grate was able to be salvaged with the other half dropping into the shaft in a vertical position. This did not interfere with backfilling. The slope above the shaft was rebuilt and straw bales were placed along the downhill side. The disturbed areas were seeded and fertilized (no mulch applied).

1993 SOUTHEASTERN MT MAINTENANCE PROJECT

The Klein Revegetation site was started on 9/30/93. Work continued here on 10/1, 10/4, 10/5, 10/6, 10/12, 10/14, 10/15, 10/18, 10/25, 10/26 and finished one tiny spot on 10/27. Many additional sites were brought up by the landowner once work had started. A coal slack pile up on the hill had been moved previously and no provisions had been made for drainage control. The water had run down the road causing deep gulling. This upper area was fixed by blading a drainage way to keep water from running down the road and the gulling was repaired. Larry Zimmerman, the landowner on the south side of the road, saw the work being done on Alan Churchill's property and ask that his unvegetated coal slack piles be addressed. Five additional areas were regraded in-place, neutralized, and revegetated.

The Sonenberg-Roth site was deleted from the package due to lack of landowner consent. One additional site was added in Judith Basin County called Lehigh. This subsidence hole adjacent to the highway was addressed on 12/14 and 12/16 after landowner consent was secured. This hole required 1,100 cubic yards of fill. A new steel shaft cover and 4 padlocks were provided (37" x 37") to secure a concrete covered shaft. The cover was painted with galvanized paint to prevent rusting.

All work was done as shown on site plans. A total of 2.92 acres were reclaimed. Two adits and 1 shaft were closed, 1 shaft was secured and a total of 6 subsidence holes were backfilled. This completed the 1993 Southeastern MT Maintenance Project.

1993 SOUTHEASTERN MT MAINTENANCE PROJECT

4.5 Quantities Used

Almost every bid item was based on a lump sum basis. This made the administration of the contract fairly straight-forward. No disputes were raised by the Contractor about the estimated quantities being wrong.

| <u>Item</u> | <u>Amount</u> | <u>Unit Cost</u> | <u>Total Cost</u> |
|--|---------------|------------------|-------------------|
| Mobilization | 8. sites | \$1187.50/site | \$9,500.00 |
| Provide Water | 0. K gals | 10.00/K gal | 0.00 |
| Salvage and Replace Cover Soil | 306. yards | 3.42/yard | 1,047.00 |
| Excavate Diversion Ditch (15 CY) | 1. each | 400.00/each | 400.00 |
| Remove and Replace Shaft Grate | 1. each | 400.00/each | 400.00 |
| Close Mine Openings (570.5 CY) | 3. each | 613.38/each | 1,840.13 |
| Rebuild Slope | 175. yards | 2.86/yard | 500.00 |
| Subsidence Backfilling | 1250. yards | 2.72/yard | 3,404.00 |
| Erosion Grading | 2. sites | 350.00/site | 700.00 |
| Excavate and Bury Coal Slack Pile | 900. yards | 3.00/yard | 2,700.00 |
| Reduce Coal Slack Pile Slopes & Bury Material | 700. yards | 2.14/yard | 1,500.00 |
| Neutralize Coal Slack | 1.22 acres | 1200.00/acre | 1,464.00 |
| Fertilize, Seed & Mulch | 2.92 acres | 1500.00/acre | 4,380.00 |
| Straw Bales for Erosion Control | 40. bales | 5.75/bale | 230.00 |
| Ditch & Road Repair | 1. each | 230.00/each | 230.00 |
| Excavate Drainage Ditch | 1. each | 350.00/each | 350.00 |
| Provide Shaft Cover | 1. each | 250.00/each | <u>250.00</u> |
| All Tasks | | | \$28,895.13 |

5. PROJECT COSTS

5.1 Pay Request

Two pay requests were processed for this project as addressed under Section 3.8 above. Copies of these two pay requests have been included in ATTACHMENT 3.

1993 SOUTHEASTERN MT MAINTENANCE PROJECT

5.2 Cost per Site

| <u>Site Name</u> | <u>Disturbed Acres</u> | <u>Cost/Acre</u> | <u>Total Project Cost</u> |
|--------------------|----------------------------|------------------|-------------------------------|
| Bryan | 0.20 | \$ 8,000.00 | \$ 1,600.00 |
| Coal Creek | 0.20 | 7,652.50 | 1,530.50 |
| Crow Rock | 0.20 | 9,855.00 | 1,971.00 |
| Leo/Anderson | 0.16 | 11,375.00 | 1,820.00 |
| Klein Revegetation | 1.61 | 5,968.32 | 9,609.00 |
| McElroy | 0.01 | 114,000.00 | 1,140.00 |
| Dandy West Upper | 0.42 | 11,246.74 | 4,723.63 |
| Lehigh | <u>0.12</u> | <u>54,175.00</u> | <u>6,501.00</u> |
| Total | 2.92 | \$ 9,895.59 | \$ 28,895.13 |

5.3 Total Project Cost

The original bid was \$20,403.00 and one change order was issued for \$8,492.13 bringing the total construction cost to \$28,895.13. The total engineering and construction management cost for the project was \$37,861.50. An analysis of the engineering costs versus construction costs is presented in ATTACHMENT 4.

6. PROJECT SUMMARY

6.1 Summary of Project

The project went as scheduled with few modifications. The only changes necessary were due to additional subsidence which had occurred from the time the bid package was prepared and the construction started. Additional work was added at the Klein site after the landowner on the south side of road saw the good work being done on the north side. One new site was added at Lehigh which had a large subsidence hole and missing shaft cover.

Baxter Construction completed the project in the allowable contract time using 37 of the 45 days available.

6.2 Site Condition after Completion

All work looked good and followed specifications. Baxter Construction, the Contractor, did a good job on this small project.

1993 SOUTHEASTERN MT MAINTENANCE PROJECT

6.3 Maintenance or Follow-up

The Coal Creek and Crow Rock sites exhibited active signs of subsidence (new holes opened up from when the engineer was shown the sites and when construction started). These sites and Dandy West Upper should be checked next spring for further subsidence or shaft opening.

6.4 Bid Package (Construction) Drawings

The bid package contained ten Site Plan sheets covering the work at the nine sites. These are located in ATTACHMENT 5 at the back of the final report. These plans represent the reclamation engineering design (the plans from which the contractors bid the work).

6.5 As-Built Drawings

The original Site Plan sheets were modified to reflect as-built final reclamation construction. These are the same plans presented right before the photographs. Since each of these sites was small, there was no need to present a complete set of pre- and post-construction drawings.

7. COMMENTS/SUGGESTIONS

On this project the engineering planning went well. The final work product accomplished all the proposed objectives.

1993 SOUTHEASTERN MT MAINTENANCE PROJECT

8. PHOTOGRAPHS/SLIDES

8.1 Listing

The description of the photographs taken to document the work performed is found at the back of the final report under ATTACHMENT 5. Each picture is numbered on the front and has a generic label on the back. Following the photo descriptions are the photos themselves. The two bound final reports contain photographs and the unbound report contains only photocopies of the photo sheets (instead of slides) per the AMRB Project Manager.

8.2 Photo Location Maps

The location where the photos were taken and their orientation are shown on the as-built plan sheets located in ATTACHMENT 5 at the back of the report.

8.3 Photos/Slides

The photographic documentation of the project includes only print film per the AMRB Project Manager.

A sequence of photographs documenting the construction activities begins immediately following the photo location maps at the back of the report.

ATTACHMENT 1

BID TABULATIONS

1993 Southeastern MT Coal Maintenance Project
Many Counties, MONTANA

DSL/AMRB 93-MO4
DATE August 20, 1993

| BID TABULATIONS | | | | ENGINEER'S ESTIMATE | | HALLETT RECLAMATION CO. | PINE STREET INC. | | BAXTER CONSTRUCTION | |
|-----------------|-----------------------|------|---|---------------------|----------------|----------------------------|------------------|-----------|---------------------|-----------|
| Item Number | Estimated Quantity | Unit | Description | Unit Price | Total Price | | | | | |
| 1. | 1 | LS | Mobilization | | 0.00 | | | 0.00 | | 0.00 |
| | 1 | | Bryan | 500.00 | 500.00 | 675.00 | 1200.00 | 1,200.00 | 1000.00 | 1,000.00 |
| | 1 | | Coal Creek | 500.00 | 500.00 | 245.00 | 750.00 | 750.00 | 500.00 | 500.00 |
| | 1 | | Crow Rock | 500.00 | 500.00 | 615.00 | 1000.00 | 1,000.00 | 1000.00 | 1,000.00 |
| | 1 | | Sonsberg-Roth | 500.00 | 500.00 | 245.00 | 500.00 | 500.00 | 1000.00 | 1,000.00 |
| | 1 | | Leo/Anderson | 500.00 | 500.00 | 1265.00 | 1500.00 | 1,500.00 | 1000.00 | 1,000.00 |
| | 1 | | Klein Revegetation | 500.00 | 1,000.00 | 735.00 | 2500.00 | 2,500.00 | 1000.00 | 1,000.00 |
| | 1 | | McElroy | 500.00 | 500.00 | 1655.00 | 800.00 | 800.00 | 1000.00 | 1,000.00 |
| | 1 | | Dandy West Upper | 500.00 | 1,000.00 | 1105.00 | 2000.00 | 2,000.00 | 1200.00 | 1,200.00 |
| 2. | 10 | KGAL | Provide water for dust suppression at all sites | 25.00 | 250.00 | 78.50 | 30.00 | 300.00 | 10.00 | 100.00 |
| 3. | 5 | LS | Salvage and replace cover soil | | 0.00 | | | 0.00 | | 0.00 |
| | 1 | LS | Bryan | 200.00 | 200.00 | 75.00 | 30.00 | 30.00 | 50.00 | 50.00 |
| | 1 | LS | Crow Rock | 200.00 | 200.00 | 75.00 | 30.00 | 30.00 | 25.00 | 25.00 |
| | 1 | LS | Sonsberg-Roth | 200.00 | 200.00 | 75.00 | 30.00 | 30.00 | 25.00 | 25.00 |
| | 1 | LS | Leo/Anderson | 200.00 | 200.00 | 155.00 | 50.00 | 80.00 | 50.00 | 80.00 |
| | 1 | LS | McElroy Site | 200.00 | 200.00 | 75.00 | 30.00 | 30.00 | 25.00 | 25.00 |
| 4. | 1 | LS | Excavate runoff diversion ditch at Dandy West Upper | 500.00 | 500.00 | 155.00 | 750.00 | 750.00 | 400.00 | 400.00 |
| 5. | 1 | LS | Remove and replace shaft grate at Dandy West | 500.00 | 1,000.00 | 740.00 | 200.00 | 200.00 | 400.00 | 400.00 |
| 6. | 3 | EA | Close mine openings | | 0.00 | | | 0.00 | | 0.00 |
| | 1 | EA | Bryan | 1500.00 | 1,500.00 | 230.00 | 50.00 | 50.00 | 250.00 | 250.00 |
| | 1 | EA | McElroy | 1500.00 | 1,500.00 | 155.00 | 50.00 | 50.00 | 100.00 | 50.00 |
| | 1 | EA | Dandy West Upper | 2000.00 | 2,000.00 | 2,640.00 | 12.00 | 12.00 | 450.00 | 450.00 |
| 7. | 1 | LS | Rebuild Slope at Shaft #1 at Dandy West Upper | 1000.00 | 1,000.00 | 3100.00 | 1750.00 | 1,750.00 | 500.00 | 500.00 |
| 8. | 3 | LS | Subsidence backfilling | | 0.00 | | | 0.00 | | 0.00 |
| | | | | | | 14,800.00 | | 13,562.00 | | 10,105.00 |

1993 Southeastern MT Coal Maintenance Project
Many Counties, MONTANA

DSL/AMRB 93-MO4
DATE August 20, 1993

| BID TABULATIONS | | | | ENGINEER'S ESTIMATE | | HALLETT RECLAMATION CO. | PINE STREET INC. | | BAXTER CONSTRUCTION |
|-----------------|-----------------------|------|---|---------------------|----------------|----------------------------|------------------|---------|---------------------|
| Item Number | Estimated Quantity | Unit | Description | Unit Price | Total Price | | | | |
| | 1 | LS | Crow Rock | 500.00 | 500.00 | 5.50 | 200.00 | 150.00 | 150.00 |
| | 1 | LS | Sonenberg-Roth | 500.00 | 500.00 | 155.00 | 300.00 | 250.00 | 250.00 |
| | 1 | LS | Leo/Anderson | 500.00 | 500.00 | 230.00 | 250.00 | 50.00 | 500.00 |
| 9. | 1 | LS | Erosion Grading | | 0.00 | | | 0.00 | 0.00 |
| | 1 | LS | Coal Creek | 1000.00 | 1,000.00 | 770.00 | 250.00 | 400.00 | 400.00 |
| | 1 | LS | Crow Rock | 500.00 | 500.00 | 460.00 | 200.00 | 300.00 | 900.00 |
| | 1 | LS | Sonenberg-Roth | 500.00 | 500.00 | 155.00 | 300.00 | 150.00 | 300.00 |
| 10. | 1 | LS | Excavate coal slack disposal pit, stockpile w/soil and spread over disturbed areas at Klein Revegetation site | 1800.00 | 1,800.00 | 2525.00 | 4500.00 | 2700.00 | 2,700.00 |
| 11. | 1 | LS | Reduce slopes on two coal slack piles and bury in disposal pit at Klein Revegetation Site | 1400.00 | 1,400.00 | 2930.00 | 2100.00 | 1500.00 | 1,500.00 |
| 12. | 0.30 | Acre | Neutralize coal slack at Klein Revegetation | 2000.00 | 1,600.00 | 2200.00 | 2500.00 | 1200.00 | 960.00 |
| 13. | 2.09 | Acre | Fertilize, Seed and mulch | | 0.00 | | | 0.00 | 0.00 |
| | 0.40 | Ac | Bryan | 1500.00 | 600.00 | 1500.00 | 2000.00 | 1500.00 | 600.00 |
| | 0.20 | Ac | Coal Creek | 1500.00 | 300.00 | 1500.00 | 2000.00 | 1500.00 | 300.00 |
| | 0.20 | Ac | Crow Rock | 1500.00 | 300.00 | 1500.00 | 2000.00 | 1500.00 | 300.00 |
| | 0.30 | Ac | Klein Revegetation | 1500.00 | 1,200.00 | 1500.00 | 2000.00 | 1500.00 | 1,200.00 |
| | 0.10 | Ac | Sonenberg-Roth | 1500.00 | 150.00 | 1500.00 | 2000.00 | 1500.00 | 150.00 |
| | 0.16 | Acre | Leo/Anderson | 1500.00 | 240.00 | 1500.00 | 2000.00 | 1500.00 | 240.00 |
| | 0.01 | Acre | McElroy | 1500.00 | 15.00 | 1500.00 | 5000.00 | 1500.00 | 15.00 |
| | 0.22 | Acre | Dandy West Upper | 1500.00 | 330.00 | 1500.00 | 2000.00 | 1500.00 | 330.00 |
| 13. | 44 | EA | Straw bales for erosion control | | 0.00 | | | 0.00 | 0.00 |
| | 14 | EA | Coal Creek | 25.00 | 350.00 | 5.50 | 10.00 | 5.75 | 80.50 |
| | 8 | EA | Crow Rock | 25.00 | 200.00 | 5.50 | 10.00 | 5.75 | 46.00 |
| | 1 | EA | Sonenberg-Roth | 25.00 | 100.00 | 5.50 | 10.00 | 5.75 | 23.00 |
| | 18 | EA | Dandy West Upper | 25.00 | 450.00 | 5.50 | 10.00 | 5.75 | 103.50 |
| | | | | | | 12,437.00 | 14,750.00 | | 10,298.00 |

H:\RECLAM\MS\PROJECT\NEMT.BID

27,237.00

28,312.00

20,403.00

ATTACHMENT 2

CHANGE ORDERS

CHANGE ORDER

RECEIVED

JAN 10 1994

STATE LANDS
ORDER NO. 1

PROJECT TITLE: 1993 Southeastern MT Maintenance Project

MONT A/E or DSL-AMRB: 93-M04

CONTRACT DATE: September 20th, 1993

OWNER: Department of State Lands, Abandoned Mine Reclamation Bureau

CONTRACTOR: Baxter Construction Company

Change Orders must be accompanied by an itemized cost breakdown. You are hereby requested to comply with the following changes from the Contract Documents. (Show separate costs for materials, labor, equipment, and miscellaneous. Show percent where applicable.)

| ITEM NO. | DESCRIPTION OF CHANGES - ESTIMATED QUANTITIES & UNITS | COST OF CHANGES | | | | | TOTAL COST |
|--|---|-----------------|-------|--------|-------|---|---|
| | | MAT'LS. | LABOR | EQUIP. | MISC. | TOTAL UNIT COST | |
| 1. | Delete Sorenberg-Roth Site due to landowner consent withdrawal by Bid Item Number 1. Mobilization 3. Salvage and Replace Cover Soil 8. Subsidence Backfill 9. Erosion Grading 13. Fertilize, Seed and Mulch (0.1 acres) 14. Straw Bales (4 bales) | | | | | (-1000) (-25) (-250) (-150) (-150) (-23) | (-1000.00) (-25.00) (-250.00) (-150.00) (-150.00) (-23.00) |
| 2. | Provide Water for Dust Suppression - None Required (Bid Item Number 2) | | | | | (-100) | (-100.00) |
| 3. | Close Mine Openings (Bid Item # 6) at Dandy West Upper air shaft 392.5 cubic yards extra x \$2.65/CY | | | | | 1040.13 | 1040.13 |
| 4. | Subsidence Backfill (Bid Item #8) Coal Creek-3 new holes (5 hrs backhoe) Crow Rock-1 new hole (3 hrs backhoe) | | | | | 250.00 150.00 | 250.00 150.00 |
| 5. | Neutralize Slack at Klein (Bid Item 12) Extra acreage at Klein of 0.02 acres Add Larry Zimmerman coal slack-0.40 acres | | | | | 24.00 480.00 | 24.00 480.00 |
| 6. | Mobilize Dump Truck to Klein with more lime for Larry Zimmerman sites - 6 hours @ \$50/hour | | | | | 300.00 | 300.00 |
| 7. | Ditch and Road Repair at Klein | | | | | 230.00 | 230.00 |
| 8. | Revegetate additional 0.81 acres at Klein | | | | | 1215.00 | 1215.00 |
| 9. | Add Lehigh site subsidence hole & shaft cover | | | | | 6501.00 | 6501.00 |
| TOTAL COST - MATERIALS, LABOR, EQUIPMENT & MISC. | | | | | | | 8,492.13 |
| OVERHEAD & PROFIT @ ____% | | | | | | | INC. |
| GRAND TOTAL - THIS CHANGE ORDER | | | | | | | \$ 8,492.13 |

| | |
|--|---------------|
| Original Contract Price | \$ 20,403.00 |
| Current Contract Price Adjusted by Previous Change Order | \$ 20,403.00 |
| Cost this Change Order (+ or -) | + \$ 8,492.13 |
| New Contract Price including this Change Order | \$ 28,895.13 |

The completion date as set forth in the Contract Documents shall be (unchanged, increased, decreased) by 0 calendar days.

The date for completion of all work was 12/16/1993.

Description and Justification for Change:

1. Sonenberg Roth site was dropped from the bid package when the landowner withdrew his verbal consent. Bid items were under mobilization (\$1,000), salvage and replace coversoil (\$25), subsidence backfill (\$250), erosion grading (\$150), fertilize, seed and mulch (0.1 acres x \$1500/ac=\$150), and straw bales (4 bales x \$5.75/bale=\$23).
2. No water was required for dust suppression (10 Kgal x \$10/Kgal=\$100).
3. Close mine openings. The air shaft at Dandy West Upper had subsided and the hole was wider and deeper once the grate was removed and you could see the extent of the workings. The original bid estimate was 170 cubic yards and a total of 562.5 cubic yards were actually put into the hole. The original bid was \$2.65/CY. The extra yardage of 392.5 CY x \$2.65/CY also matches the equipment hours times the unit rate per hour so either method gives the same extra cost.
4. Subsidence Backfill. Three new subsidence holes opened up at Coal Creek. These holes were 6'x12'x6'D, 8'x8'x6'D, and 12'x12'x6'D. This took 5 hours of Case backhoe time to fix (5 hrs x \$50/hr=\$250). The two little gopher sized holes at Crow Rock had opened up to a major subsidence hole of dimensions 12'x20'x8'D. This took an additional 3 hours of Case backhoe time to fix (3 hours x \$50/hour=\$150).
5. Neutralize coal slack at Klein. An extra 0.02 acres were limed at Klein plus 0.40 acres were added and limed on Larry Zimmerman's property directly south of Alan Churchill's.
6. Larry Zimmerman's coal slack areas were added to the project right before project completion. This required the Contractor to make an extra trip to Warren (remobilize) to get more lime (6 hours dump truck x \$50/hour= \$300).
7. Ditch and road repair of washout at Klein in previously reclaimed area (2 hours Case 580 backhoe @ \$50/hour plus 2 hours of motor grader at \$65/hour).
8. Revegetate. Additional areas (1.61 total acres or 0.81 more than bid amount) at Klein were revegetated (more coal slack areas and ditch & road repair on Churchill's and 0.4 acres on Larry Zimmerman's).
9. Add Lehigh site. Large subsidence hole and shaft cover. Took 1100 cy of fill @ \$2.14/cy, 289 cy of salvage & replace topsoil @ \$3/cy, revegetate 0.12 acres @ \$1500/acre, excavate drainage ditch @ \$350, provide galvanize painted steel shaft cover with 4 new padlocks @ \$250 plus mobilization of scraper and backhoe at \$2.20/loaded mile plus bonds and insurance at \$2,500 for a total of \$6,501.

SURETY CONSENT

The Surety hereby consents to the aforementioned Contract Change Order and agrees that its bond or bonds shall apply and extend to the Contract as thereby modified or amended per this Change Order. The Principal and the Surety further agree that on or after execution of this consent, the penalty of the applicable Performance Bonds or Bonds is hereby increased by \$ 8,492.13 (100% of the Change Order amount) and the penalty of the applicable Labor and Material Bond or Bonds is hereby increased by \$ 8,492.13 (100% of the Change Order amount).

COUNTERSIGNED BY MONTANA
RESIDENT AGENT

HOINESS LaBAR INSURANCE, INC.

Countersigned by:

Kip W. Vandeventer
Montana Resident Agent

SURETY

Transamerica Premier Insurance Company

BY: Kip W. Vandeventer

By: Kip W. Vandeventer, Attorney-in-fact

Seal

Recommended by: Spectrum Engineering

Engineer

William C. MacRae 12/23/93

Date

Accepted by: Baxter Construction Company

Contractor

Ed Baxter

12/28/93

Date

Approved by: U. R. Anders

Owner

11/11/94

Date

ATTACHMENT 3

PAYMENT REQUESTS

443

| Item No. | Description | Contract Quantity | Contract Unit Price | Previous Quantity Requested | Current Quantity Completed | Total Quantity Completed to Date | Total Contract Amount Completed to Date | Amount Due this Payment |
|---------------|---|-------------------|---------------------|-----------------------------|----------------------------|----------------------------------|---|-------------------------|
| 1. | Mobilization | 1 LS | 7700.00 | 0 | 0.87 | 0.87 | 6700.00 | 6700.00 |
| 2. | Provide Water | 10 Kgal | 10.00 | 0 | 0 | 0 | 0.00 | 0.00 |
| 3. | Salvage & Replace Coversoil | 1 LS | 205.00 | 0 | 0.88 | 0.88 | 180.00 | 180.00 |
| 4. | Excavate Run-off Diversion Ditch at Dandy West | 1 LS | 400.00 | 0 | 1 | 1 | 400.00 | 400.00 |
| 5. | Remove and Replace Grate at Dandy West | 1 LS | 400.00 | 0 | 1 | 1 | 400.00 | 400.00 |
| 6. | Close Mine Openings | 3 Each | 266.67 | 0 | 3 | 3 | 800.00 | 800.00 |
| 7. | Rebuild Slope at Dandy West | 1 LS | 500.00 | 0 | 1 | 1 | 500.00 | 500.00 |
| 8. | Subsidence Backfilling | 1 LS | 900.00 | 0 | 0.72 | 0.72 | 650.00 | 650.00 |
| 9. | Erosion Grading | 1 LS | 850.00 | 0 | 0.82 | 0.82 | 700.00 | 700.00 |
| 10. | Excavate Coal Slack Pit & Topsoil Handling at Klein | 1 LS | 2700.00 | 0 | 1 | 1 | 2700.00 | 2700.00 |
| 11. | Reduce Slopes on Coal Slack Piles at Klein | 1 LS | 1500.00 | 0 | 1 | 1 | 1500.00 | 1500.00 |
| 12. | Neutralize Coal Slack at Klein | 0.80 Acres | 1200.00 | 0 | 0.80 | 0.80 | 960.00 | 960.00 |
| 13. | Fertilize, Seed and Mulch | 2.09 Acres | 1500.00 | 0 | 1.99 | 1.99 | 2985.00 | 2985.00 |
| 14. | Straw Bales | 40 Each | 5.75 | 0 | 40 | 40 | 230.00 | 230.00 |
| | Materials on Site (Attach Schedule) | -- | -- | \$ | \$ | -- | \$0.00 | \$0.00 |
| TOTALS | | | | | | | \$18,705.00 | \$18,705.00 |

PAYMENT REQUEST NO. 2

RECEIVED

JAN 10 1994

FROM 10/20/1993 TO 12/16/1993

STATE LANDS

PROJECT TITLE: 1993 SOUTHEASTERN MT COAL MAINTENANCE PROJECT

LOCATION: SOUTHEASTERN MONTANA MONT A/E or DSL-AMRB: 93-M04

NAME OF CONTRACTOR: BAXTER CONSTRUCTION COMPANY

ADDRESS: 4014 HARDIN ROAD, BILLINGS, MT 59101

SUMMARY OF PROJECT STATUS

| | | |
|------------------------------------|----|-------------------------|
| Amount of Original Contract | \$ | <u>20,403.00</u> |
| Change Order No. <u>1</u> | \$ | <u>8,492.13</u> |
| Change Order No. <u> </u> | \$ | <u> </u> |
| Change Order No. <u> </u> | \$ | <u> </u> |
| Amount of Approved Change Order(s) | \$ | <u>8,492.13</u> |
| TOTAL CONTRACT AMOUNT | \$ | <u>28,895.13</u> |

| Pay Request No. | Amount of Request |
|-----------------|-------------------|
| 1 | \$18,705.00 |
| 2 | \$10,190.13 |
| | |
| | |
| | |

| | | |
|---|----|-------------------------|
| Total Contract Amount Completed to Date | \$ | <u>28,895.13</u> |
| Less Retainage (<u>0</u> %) | \$ | <u>0.00</u> |
| TOTAL AMOUNT EARNED TO DATE | \$ | <u>28,895.13</u> |
| Less Previous Payments | \$ | <u>16,834.50</u> |
| AMOUNT DUE THIS PAYMENT | \$ | <u>12,060.63</u> |
| Less 1% Tax | \$ | <u>120.61</u> |
| TOTAL DUE CONTRACTOR | \$ | <u>11,940.02</u> |

I certify that this claim is correct and just in all respects and that payment or credit has not been received.

APPROVED BY:

DEPARTMENT OF STATE LANDS, ABANDONED
MINE RECLAMATION BUREAU

Owner

By Vicki L. Anderson

Date 1/11/94

BAXTER CONSTRUCTION COMPANY

Contractor

By Ed Baxter

Date 12/28/93

RECOMMENDED BY:

SPECTRUM ENGINEERING

Engineer

By William C. Maerz

Date 12/23/93

| Item No. | Description | Contract Quantity | Contract Unit Price | Previous Quantity Requested | Current Quantity Completed | Total Quantity Completed to Date | Total Contract Amount Completed to Date | Amount Due this Payment |
|---------------|---|-------------------|---------------------|-----------------------------|----------------------------|----------------------------------|---|-------------------------|
| 1. | Mobilization | 1 LS | 7700.00 | 0 | 0.87 | 0.87 | 6700.00 | 6700.00 |
| 2. | Provide Water | 10 Kgal | 10.00 | 0 | 0 | 0 | 0.00 | 0.00 |
| 3. | Salvage & Replace Coversoil | 1 LS | 205.00 | 0 | 0.88 | 0.88 | 180.00 | 180.00 |
| 4. | Excavate Run-off Diversion Ditch at Dandy West | 1 LS | 400.00 | 0 | 1 | 1 | 400.00 | 400.00 |
| 5. | Remove and Replace Grate at Dandy West | 1 LS | 400.00 | 0 | 1 | 1 | 400.00 | 400.00 |
| 6. | Close Mine Openings | 3 Each | 266.67 | 0 | 3 | 3 | 800.00 | 800.00 |
| 7. | Rebuild Slope at Dandy West | 1 LS | 500.00 | 0 | 1 | 1 | 500.00 | 500.00 |
| 8. | Subsidence Backfilling | 1 LS | 900.00 | 0 | 0.72 | 0.72 | 650.00 | 650.00 |
| 9. | Erosion Grading | 1 LS | 850.00 | 0 | 0.82 | 0.82 | 700.00 | 700.00 |
| 10. | Excavate Coal Slack Pit & Topsoil Handling at Klein | 1 LS | 2700.00 | 0 | 1 | 1 | 2700.00 | 2700.00 |
| 11. | Reduce Slopes on Coal Slack Piles at Klein | 1 LS | 1500.00 | 0 | 1 | 1 | 1500.00 | 1500.00 |
| 12. | Neutralize Coal Slack at Klein | 0.80 Acres | 1200.00 | 0 | 1.22 | 1.22 | 1464.00 | 1464.00 |
| 13. | Fertilize, Seed and Mulch | 2.09 Acres | 1500.00 | 0 | 2.08 | 2.08 | 4200.00 | 4200.00 |
| 14. | Straw Bales | 40 Each | 5.75 | 0 | 40 | 40 | 230.00 | 230.00 |
| | CHANGE ORDER 1 | | | | | | | |
| | Dandy West Upper Extra CY | 392.5 CY | 2.65 | 0 | 392.5 | 392.5 | 1040.13 | 1040.13 |
| | Extra Subsidence filling with backhoe | 8 Hours | 50.00 | 0 | 8 | 8 | 400.00 | 400.00 |
| | Extra Mobilization | 6 Hours | 50.00 | 0 | 6 | 6 | 300.00 | 300.00 |
| | Ditch/Road Repair (backhoe & grader) | 2 Hours | 115.00 | 0 | 2 | 2 | 230.00 | 230.00 |
| | Lehigh Subsidence | 1 LS | 6501.00 | 0 | 1 | 1 | 6501.00 | 6501.00 |
| | Materials on Site (Attach Schedule) | -- | -- | \$ | \$ | -- | \$0.00 | \$0.00 |
| TOTALS | | | | | | | \$28,895.13 | \$28,895.13 |

ATTACHMENT 4

ANALYSIS OF CONSULTANT COSTS INCURRED

ANALYSIS OF CONSULTANT COSTS INCURRED
FOR THE MONTANA DEPARTMENT OF STATE LANDS
ABANDONED MINE RECLAMATION BUREAU

AMRB PROJECT NUMBER: DSL-AMRB 93-M04
1993 SOUTHEASTERN MT MAINTENANCE PROJECT

DATE OF PREPARATION: December 30th, 1993

| ENGINEERING SERVICE | AMOUNT |
|---|-------------|
| DESIGN ENGINEERING: | \$22,748.38 |
| CONSTRUCTION ENGINEERING AND PROJECT ADMINISTRATION COST: | \$15,113.12 |
| TOTAL PROJECT ENGINEERING COST: | \$37,861.50 |
| CONSTRUCTION COST: | \$28,895.13 |
| PERCENTAGE ENGINEERING FEES TO CONSTRUCTION COST: | |
| DESIGN ENGINEERING/CONSTRUCTION COST | 78.73% |
| CONSTRUCTION ENGINEERING/CONSTRUCTION COST | 52.30% |
| TOTAL ENGINEERING COST/CONSTRUCTION COST | 131.03% |

REMARKS: Services provided included landowner contact and consent, surveying, basic engineering and reclamation design, bid document preparation, pre-bid and pre-construction meetings, construction staking, contract administration, quantity accounting, full time construction/reclamation inspection and final report preparation and project close-out.

ATTACHMENT 5

AS-BUILT DRAWINGS

AND

PHOTO LOCATIONS

LANDOWNER/CONTACT LIST

| SITE NAME/LOCATION | LANDOWNER/CONTACT | SITE NAME/LOCATION | LANDOWNER/CONTACT |
|---|---|---|---|
| POWDER RIVER COUNTY | | | |
| Bryan Site SW¼NE¼ Sec 18, T3S, R46E | Custer National Forest Ashland Ranger District Bill Ott, District Ranger P.O. Box 168 Ashland, MT 59003 406-784-2344 | McElroy NW¼NW¼ Sec 36, T4S, R22E | LANDOWNER State of Montana (All of Sec 36) c/o Dept. of State Lands Jeff Hagener, Chief Surface Management Bureau Land Administration Division 1625 11th Avenue Helena, MT 59620 406-444-2074 |
| Coal Creek Site NE¼NW¼ Sec 3, T3S, R45E | Great Northern Properties Attn: Steven Shirley 1101 North 27th Street - Suite 201 Billings, MT 59101 406-248-4885 | | ACCESS OWNER AND LESSEE Lessee for All of Section 36 and Owner of Access Route in Section 25 Mrs. Mary David P.O. Box 215 Joliet, Montana 59041 406-962-3433 |
| CUSTER COUNTY | | | |
| Crow Rock Site SW¼ Sec 17, T12N, R45E | Great Northern Properties Attn: Steven Shirley 1101 North 27th Street - Suite 201 Billings, MT 59101 406-248-4885 | Dandy West Upper NE¼NE¼ Sec 8, T9S, R27E | LANDOWNER Bureau of Land Management Ken Hanly Billings Resource Area 810 E. Main Billings, MT 59105 406-657-6262 |
| MUSSELSHELL COUNTY | | | |
| Klein Revegetation NW¼SW¼ Sec 36, T8N, R25E | Alan Churchill 1219 2nd East Box 987 Roundup, MT 59072 406-323-1180 or 323-2403 | | MINERAL CLAIMANT James J. Stoick 1600 Avenue E Billings, MT 59102 406-252-1438 |
| GARFIELD COUNTY | | | |
| Sonenberg-Roth Sec 15, T18N, R37E | Coleman & Virginia Lou Murnion P.O. Box 13 Jordan, MT 59337 406-557-2251 | | |
| JUDITH BASIN COUNTY | | | |
| Leo/Anderson NE¼NE¼ Sec 26 T19N, R38E | Ted & Jack Binion (Landowners) Binion's Horseshoe Casino Las Vegas, NV 89101 702-382-1600 James P. Lucas (Contact) Attorney-at-Law P.O. Box 728 Miles City, MT 59301 406-232-4070 Greg Severe (Ranch Manager) Binion Ranch, Haxby Route Jordan, MT 59337 406-557-2529 | Leihigh Sec. 21, T15N, R12E | LANDOWNER Gayle Evans Box 55 McCall Creek, MS 39647 601-835-0684 |

STORM WATER CONTROL BEST MANAGEMENT PRACTICES (BMP'S)

| SITE NAME | LEGAL | DISTURBED ACRES | TIME LAPSE | SURFACE WATER LOCATION | TEMPORARY SEDIMENT- ATION & EROSION CONTROL | PERMANENT STABILIZATION | AS-BUILT ACRES |
|--------------------|-------------------------|--------------------|---------------|------------------------------|---|----------------------------|-------------------|
| BRYAN | T3S, R46E, SEC. 18 NE¼ | 0.40 | 2 | adjacent | MULCH | PERMANENT SEEDING | 0.20 |
| CDAL CREEK | T3S, R45E, SEC. 3 NW¼ | 0.20 | 1 | 1 | MULCH STRAW BALES | PERMANENT SEEDING | 0.20 |
| CROW ROCK | T12N, R45E, SEC. 17 SW¼ | 0.20 | 2 | 0.2 | MULCH STRAW BALES | PERMANENT SEEDING | 0.20 |
| KLEIN REVEGETATION | T8N, R25E, SEC. 36 SW¼ | 0.80 | 5 | 0.1 | MULCH | PERMANENT SEEDING | 1.61 |
| SDNENBERG-ROTH | T18N, R37E, SEC. 15 SE¼ | 0.10 | 2 | 0.08 | MULCH STRAW BALES | PERMANENT SEEDING | DROPPED |
| LED/ANDERSON | T19N, R38E, SEC. 26 NE¼ | 0.16 | 1 | 0.2 | MULCH | PERMANENT SEEDING | 0.16 |
| McELROY | T4S, R22E, SEC. 36 NW¼ | 0.01 | 1 | 0.3 | MULCH | PERMANENT SEEDING | 0.01 |
| DANDY WEST UPPER | T9S, R27E, SEC. 8 NE¼ | 0.22 | 5 | 1.5 | STRAW BALES | PERMANENT SEEDING | 0.42 |
| LEIGHIGH | T15N, R12E, SEC. 21 | | | | | | 0.12 |
| TOTAL ALL SITES | | 2.09 ¹ | | | | | |

The purpose of this project is to reclaim abandoned coal mines and a uranium mine. All of the sites addressed herein were previously reclaimed and require some additional maintenance work. The construction activity will include salvaging and replacing cover soil; providing water for dust control; excavating runoff diversion ditches; removing and replacing a shaft grate; rebuilding a slope; closing mine adits and shafts; backfilling subsidence; regrading erosional areas; and neutralizing coal slack. Temporary sedimentation and erosion control includes mulching and straw bales. Permanent stabilization includes permanent seeding and fertilizing all disturbed areas.

The Owner is the Department of State Lands, Reclamation Division, Abandoned Mine Reclamation Bureau, 1625 11th Avenue, Helena, Montana 59620 at telephone 1-444-2074. The Project Manager is Joel Chavez.

Good housekeeping for petroleum products, wastes, fertilizer and off-site tracking will be followed by the Contractor as outlined in MPDES Stormwater Discharge Permit and Erosion Control Plan. Good housekeeping chores will include as a minimum:

- To prevent tracking of sediment off site, prior to leaving the site, all vehicles shall be washed down on-site as determined by the Engineer at such a location as to contain all washed sediment on site.
- Fuel, oil, grease and other such materials shall be stored in one location at each site in such a manner as to prevent spillage and prevent contamination of the surrounding soil. All materials shall be stored in a bermed plastic lined storage area with a capacity of 110 percent of the largest container. Absorbent material shall be available on-site for clean up of any spills; and,
- Lime and fertilizer shall be stored on pallets off the ground or on plastic ground covers and covered with plastic or in other such manner as to prevent spillage and washing from rain water or wind into surrounding soil or off-site.

FDDTNDTES


- Estimated time period in days from the start of on-site reclamation construction until the site is permanently fertilized and seeded (long term erosion controls are installed). This is the time from site arrival until demobilization (weather dependant). Temporary stabilization will include mulch and straw bales as outlined above.
- The distance in miles to the nearest source of potential surface water either flowing or ponded including lakes, rivers, and streams (perennial, intermittent or current dry drainages).
- 100% of all disturbed areas will be revegetated prior to leaving the site.

1993 SOUTHEASTERN MT. MAINTENANCE PROJECT


LOCATED IN
GARFIELD, MUSSELSHELL, CARBON, POWDER RIVER & CUSTER COUNTIES, MONTANA

DSL/AMRB 93-M04

PREPARED FOR:
MONTANA DEPARTMENT OF STATE LANDS
ABANDONED MINE RECLAMATION BUREAU

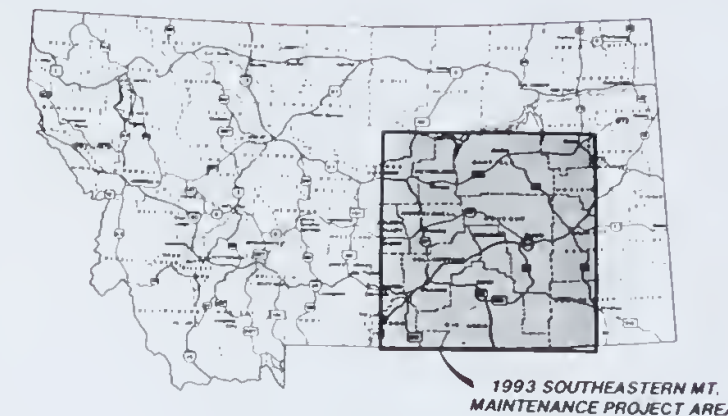

STATE LOCATION MAP

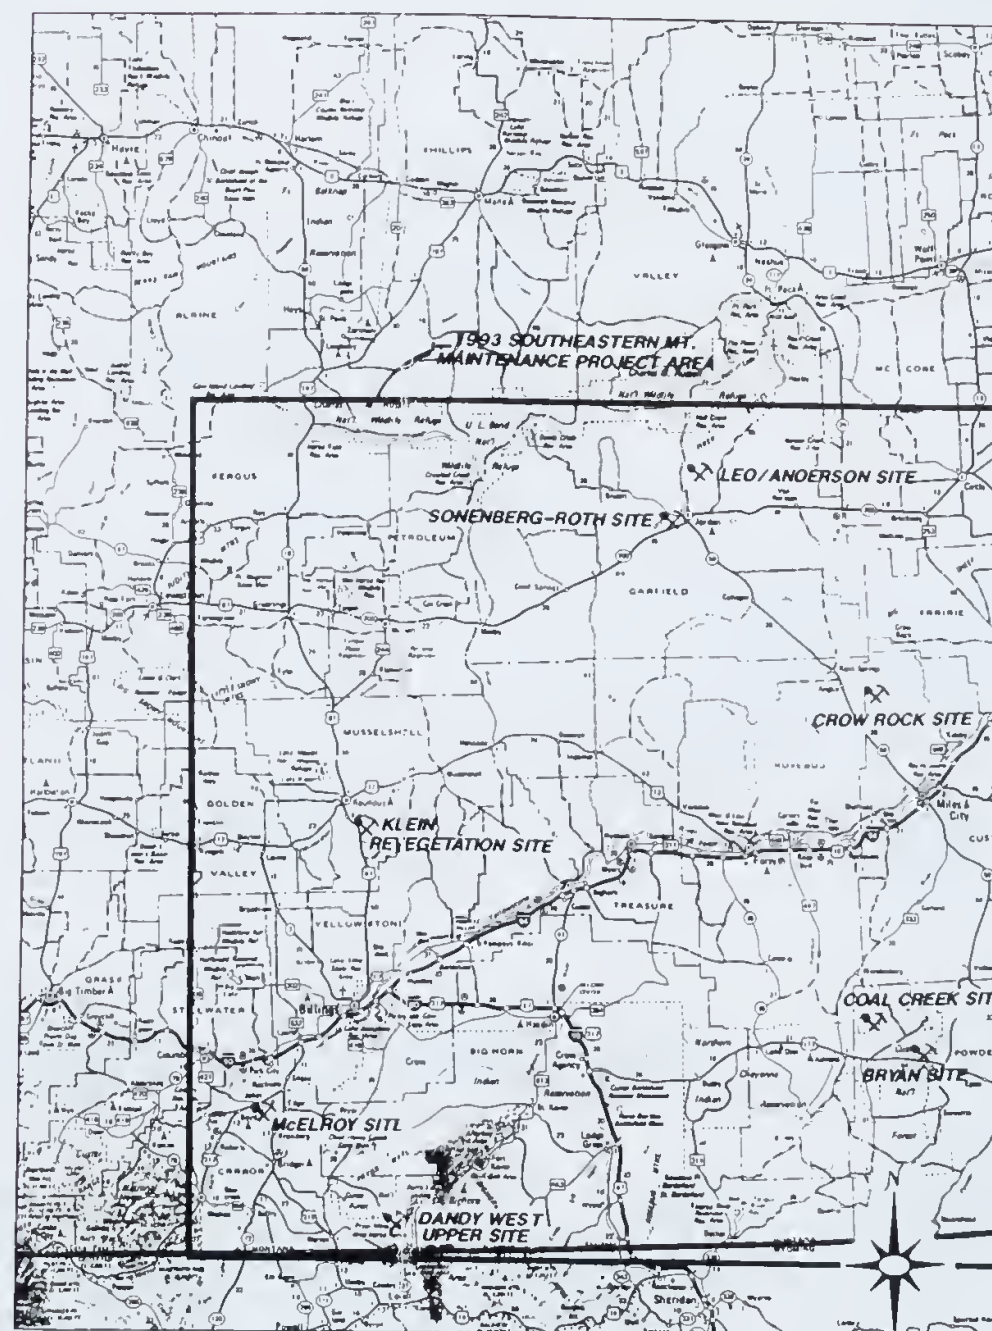

AREA MAP



ARCHAEOLOGICAL NOTICE

ANY KNOWN ARCHAEOLOGICAL MATERIALS NEAR THE CONSTRUCTION AREAS WILL BE MARKED BY THE OWNER. AT NO TIME SHALL THESE ARCHAEOLOGICAL MATERIALS BE DISTURBED WITHOUT WRITTEN PERMISSION FROM THE OWNER.

HAZARD NOTICE

MANY POTENTIAL HAZARDS EXIST AT THESE SITES. THE EXTENT OF THESE HAZARDS IS NOT FULLY KNOWN.

THE CONTRACTOR, SUBCONTRACTORS, AND THEIR EMPLOYEES WILL COMPLY WITH ALL APPLICABLE LOCAL, STATE, AND FEDERAL SAFETY REGULATIONS IN THE PERFORMANCE OF THE REQUIRED WORK. CONTRACTORS AND OTHER PERSONS WORKING AT THE SITES SHALL BE FULLY RESPONSIBLE FOR APPRISING THEMSELVES OF ANY HAZARDOUS CONDITIONS WHICH MAY EXIST AND SHALL TAKE WHATEVER STEPS ARE NECESSARY TO INSURE THEIR SAFETY AND THE SAFETY OF OTHERS WHILE PERFORMING THEIR DUTIES.

MAP SHEET INDEX

| DESCRIPTION | SHEET NO. |
|--------------------|-----------|
| COVER SHEET | 1 |
| BRYAN | 2 |
| COAL CREEK | 3 |
| CROW ROCK | 4 |
| SONENBERG-ROTH | 5 |
| LEO/ANDERSON | 6 |
| KLEIN REVEGETATION | 7 |
| McELROY | 8 |
| DANDY WEST UPPER | 9 |
| LEIGHIGH | 10 |

ENGINEER'S CERTIFICATE

THE MAPS AND PLANS WHICH FOLLOW WERE ORIGINALLY PREPARED UNDER THE DIRECTION OF VARIOUS ENGINEERS AND FIRMS IN ORDER TO COMPLETE SITE RECLAMATION WORK OVER THE LAST 10 YEARS. THESE PLANS WERE NOT ALTERED. THE 1993 SOUTHEASTERN MT. MAINTENANCE PROJECT USES THE ORIGINAL PLANS WITH THE MAINTENANCE WORK IDENTIFIED IN A DIFFERENT TYPOGRAPHIC STYLE. ONLY THE WORK IDENTIFIED AS MAINTENANCE ON THESE SITE PLANS AND IN THE BID PACKAGE IS TO BE COMPLETED.

I HEREBY CERTIFY THAT THE MAINTENANCE WORK SHOWN ON THESE MAPS AND PLANS WAS PREPARED BY ME OR UNDER MY DIRECT SUPERVISION. I CANNOT ACCOUNT FOR THE ACCURACY OF THE ORIGINAL SITE PLANS AND THE WORK PERFORMED. LIKEWISE THE ENGINEER WHO STAMPED THE ORIGINAL PLANS ASSUMES NO RESPONSIBILITY FOR THE MAINTENANCE WORK ADDITIONS.


William C. Mashi
William C. Mashi
Montana P.E. No. 5274 PE

ADDITIONAL INFORMATION PERTAINING TO THESE SITES MAY EXIST IN THE DEPARTMENT OF STATE LANDS' FILES OR AT SPECTRUM ENGINEERING'S OFFICE. THIS MATERIAL IS AVAILABLE FOR REVIEW BY ANY INTERESTED PARTY.

REDUCED PRINTS ARE APPROX. 1/2 ORIGINAL SCALE

PREPARED BY:
SPECTRUM ENGINEERING
Mining and Civil Engineers

4th Avenue Plaza
1413 4th Avenue North
Billings, Montana 59101

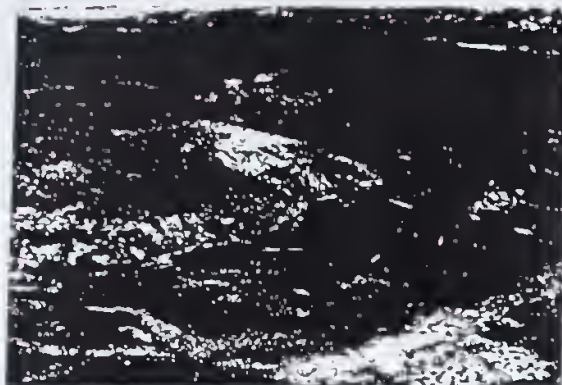

① PICTURE 1 IS AN AERIAL VIEW OF THE BRYAN SITE



② PICTURE 2 SHOWS THE ADIT, COAL SLACK AREA, AND DEBRIS



③ PICTURE 3 SHOWS THE PARTIALLY BLOCKED ADIT ENTRANCE

STORM WATER POLLUTION PREVENTION AND EROSION CONTROL PLAN BEST MANAGEMENT PRACTICES FOR STORM WATER CONTROL

The Owner is the Department of State Lands, Reclamation Division, Abandoned Mine Reclamation Bureau, 1625 11th Avenue, Helena, Montana 59620 at telephone 1-444-2074. The project manager is Joet Chavez.


The construction activity is described in the Coal Maintenance Work Description. The reclamation construction is estimated to disturb and reclaim 0.40 acres during this project. This site is located in the SW 1/4 NE 1/4 of Sec. 18 T3S, R46E, Powder River County

The estimated time period will be two days from the start of on-site reclamation construction until the site is permanently fertilized seeded and mulched (long term erosion controls are installed). This is the time from site arrival until demobilization (weather dependant).

This site is located adjacent to Coal Bank Spring which flows into Home Creek which flows into Otter Creek which flows into the Tongue River

Best Management Practices (BMP's) during construction to control sediment and erosion in storm runoff. Temporary stabilization practices - mulching entire area to be revegetated, and Permanent stabilization practices - seeding and fertilizing (100% revegetation of the site).

Good housekeeping for petroleum products, wastes, fertilizer and off-site tracking will be followed by the contractor as outlined by the MPDES Storm Water discharge permit erosion control plan.

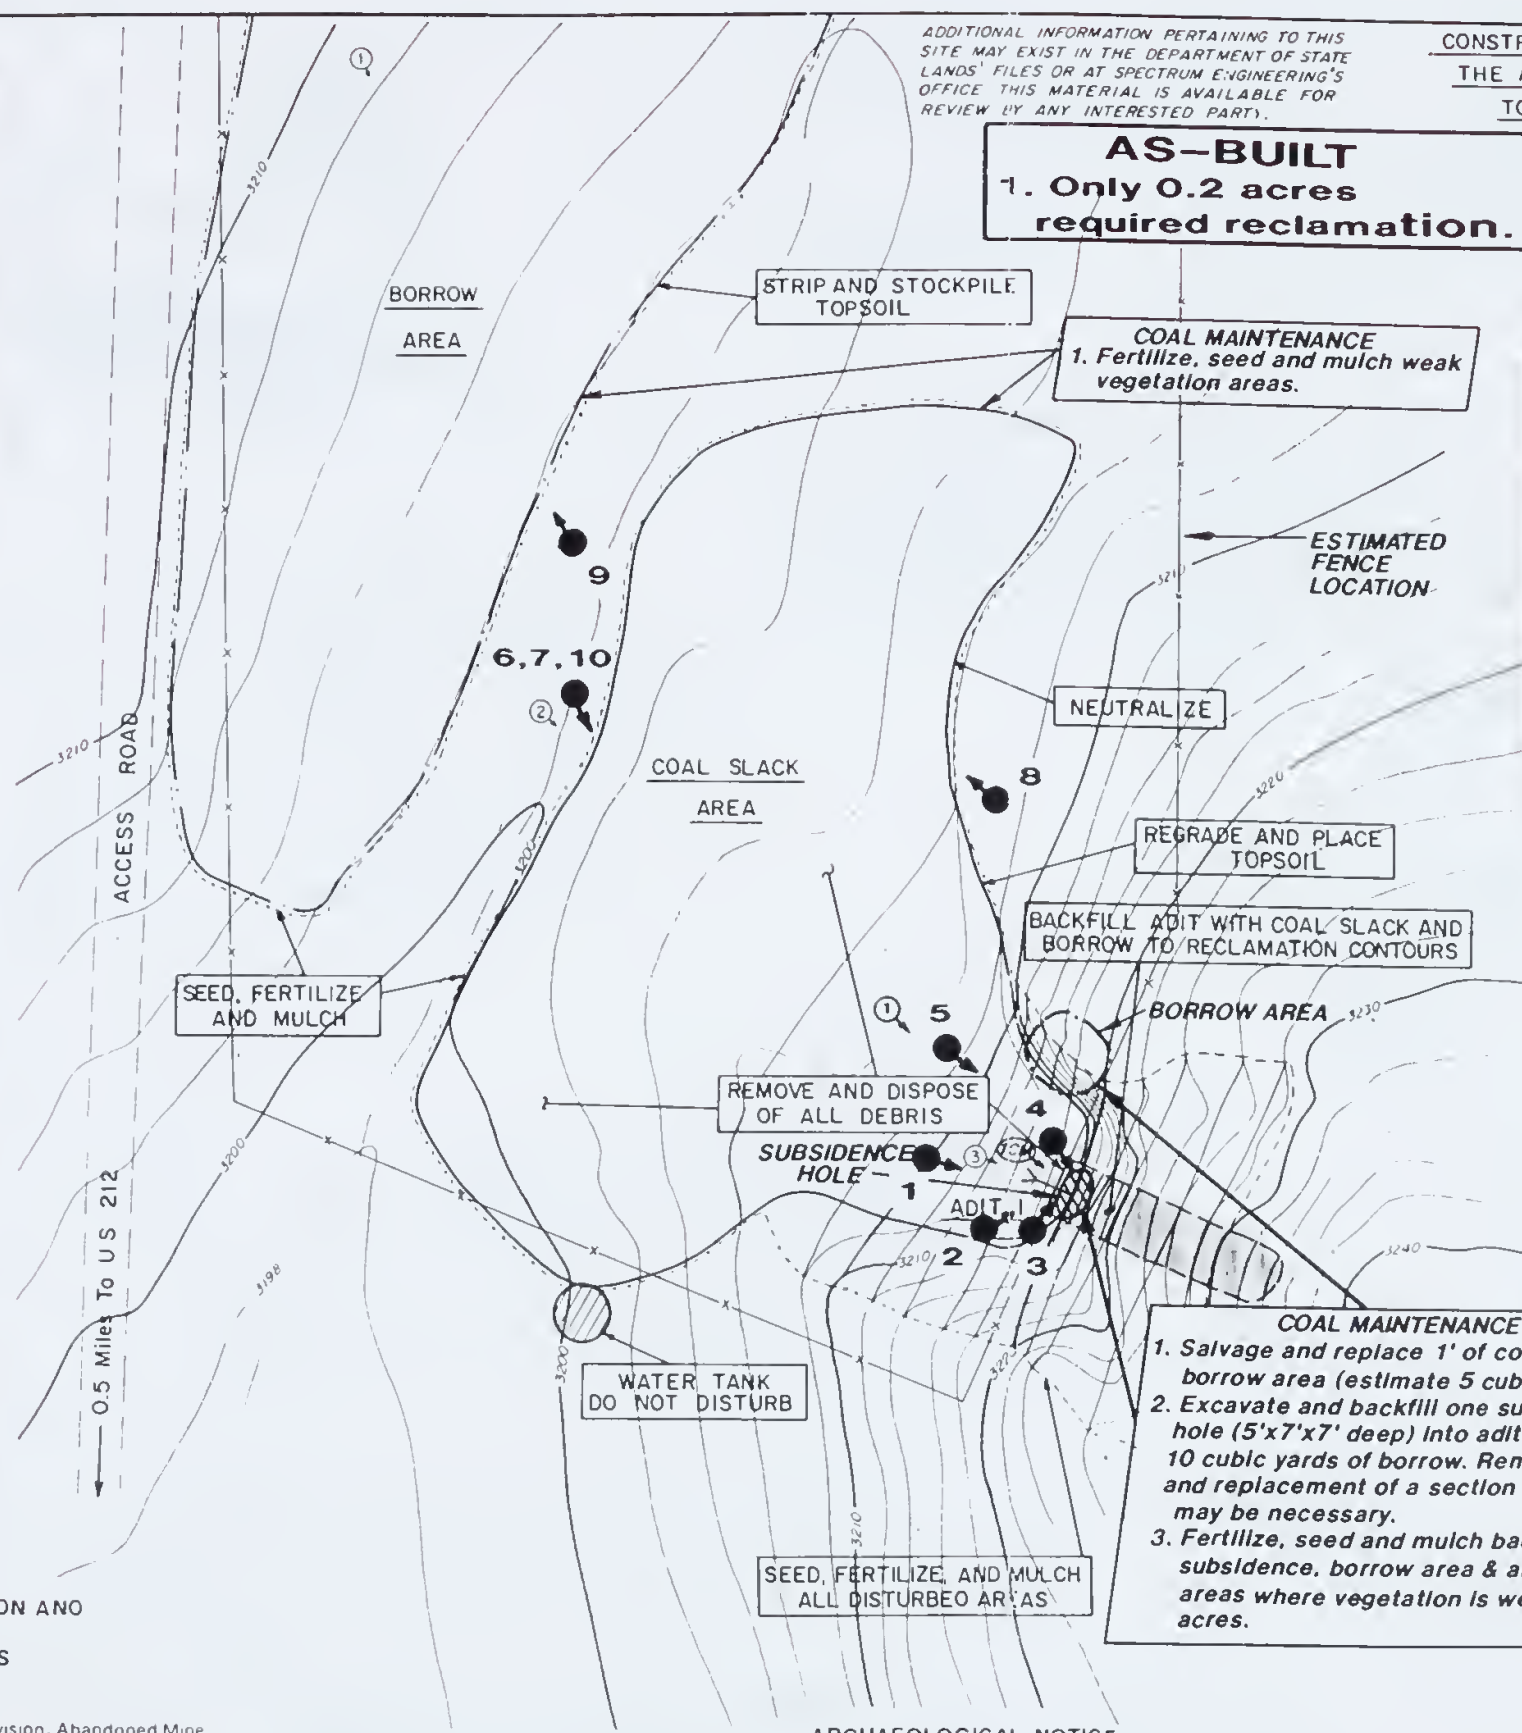


REDUCED PRINTS ARE APPROX.
1/2 ORIGINAL SCALE

CONSTRUCTION PHOTOS

CONSTRUCTION IS LIMITED TO
THE AREA SHOWN ON THIS
TOPOGRAPHIC MAP

VEHICLE TRAVEL WILL BE LIMITED
TO ROUTES FLAGGED ON-SITE BY
THE PROJECT ENGINEER

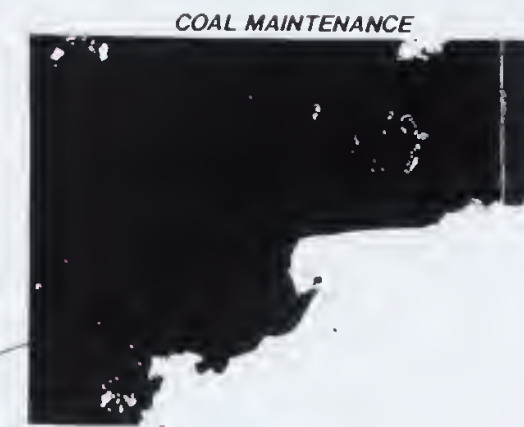

(CM) Picture 1 is looking southeast at the subsidence into the adit.


LANDOWNER AND CONTACT
SECTION 18, T3S, R46E

CUSTER NATIONAL FOREST
BILLINGS, MT

% ASHLAND RANGER DISTRICT
CUSTER NATIONAL FOREST
BILL OTT, DISTRICT RANGER
P O BOX 16B
ASHLAND, MT 59003
PHONE (406) 7B4-2344



STATE LOCATION MAP
BRYAN PROJECT SITE

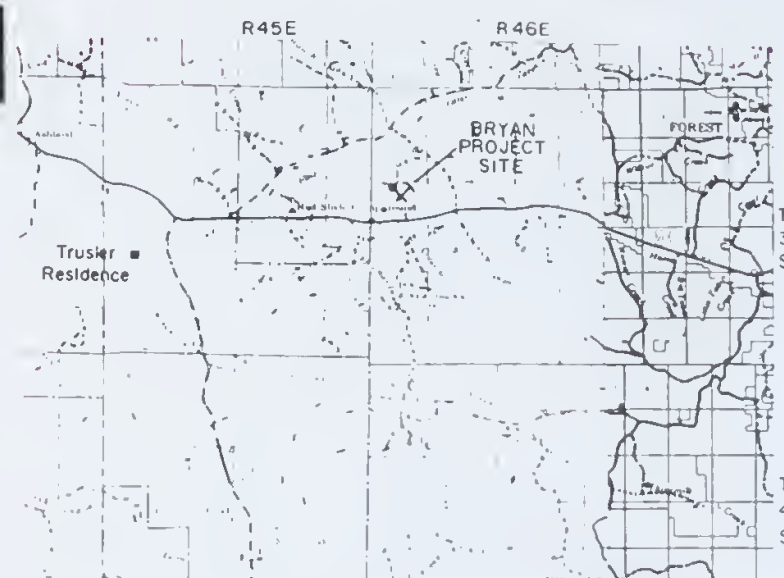

SITE LOCATION MAP
COLEMAN DRAW, MT 7 1/2 USGS

SITE PLAN AND GENERAL LAYOUT

BRYAN SITE
SECTION 18, T3S, R46E
POWDER RIVER COUNTY, MONTANA

STATE OF MONTANA
DEPARTMENT OF STATE LANDS
ABANDONED MINE RECLAMATION BUREAU, RECLAMATION DIVISION

SPECTRUM ENGINEERING
Mining and Civil Engineers

1413 4th AVE NORTH
BILLINGS, MONTANA

| | |
|------------------|---------------|
| DATE August 1990 | DRAWN BY: DLO |
| APPROVED BY: GWR | REVISIONS |
| NO | DATE |
| BY | |
| SHEET NO 5 of 11 | |

NOTICE

AN ABANDONED COAL MINE UNDERLIES THIS SITE. MANY POTENTIAL HAZARDS EXIST. THE EXTENT OF THESE HAZARDS IS NOT FULLY KNOWN. CONTRACTORS AND OTHER PERSONS WORKING AT THE SITE SHALL APPRISE THEMSELVES OF THE CONDITIONS AND TAKE WHATEVER STEPS ARE DEEMED NECESSARY TO INSURE SAFETY WHILE PERFORMING THEIR DUTIES.

AS-BUILT DRAWING AND PHOTO INDEX

ANY KNOWN ARCHAEOLOGICAL MATERIALS NEAR THE CONSTRUCTION AREAS WILL BE MARKED BY THE OWNER. AT NO TIME SHALL THESE ARCHAEOLOGICAL MATERIALS BE DISTURBED WITHOUT THE WRITTEN PERMISSION FROM THE OWNER.


VEHICLE TRAVEL WILL BE LIMITED
TO ROUTES FLAGGED ON-SITE BY
THE PROJECT ENGINEER.



① PICTURE 1 SHOWS SUBSIOENCE PIT 1

② PICTURE 2 SHOWS SP-2

AS-BUILT
Three new subsidence holes were backfilled and revegetated.

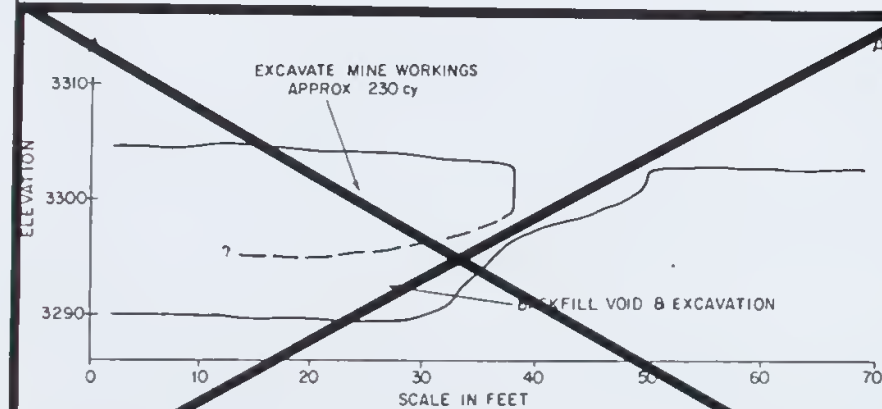 CONSTRUCTION PHOTOS

SECTION A-A'

WORK SUMMARY TABLE

| ITEM | DESCRIPTION | ACTION | QUANTITY |
|-----------------|-------------------------|----------------------|-----------------------------|
| TOPSOIL | SUBSIDENCES/BORROW AREA | STRIP AND STOCKPILE | 40 CY |
| TOTAL (EST.) | STOCKPILES | PLACE FROM STOCKPILE | <u>40 CY</u> 80 CY |
| SUBSIDENCES | | | |
| SP 1 | SEE TOPOGRAPHIC MAP | BACKFILL | 15 CY |
| SP 2 | SEE TOPOGRAPHIC MAP | BACKFILL | <u>5 CY</u> |
| TOTAL (EST.) | | | 20 CY |
| WATER | BACKFILL | FOR COMPACTION | 3.0 KGAL |
| | ROADS AND OTHER AREAS | DUST SUPPRESSION | <u>1.0 KGAL</u> 4.0 KGAL |
| MINE WORKINGS | SEE MAP | EXCAVATE | 230 CY |
| | | BACKFILL | 230 CY |
| | | BACKFILL WITH BORROW | <u>30 CY</u> 480 CY |
| DISTURBED AREAS | SUBSIDENCE AND BORROW | REVEGETATE | 0.10 ACRES |
| TOTAL (EST.) | AREA | | |
| REVEGETATION OF | FERTILIZER AT 92.5 LBS | APPLY | 9 POUNDS |
| 0.10 ACRES | SEED AT 23 LBS PLS | DRILL SEED | 23 LB PLS |
| | HAY MULCH AT 3,000 LBS | SPREAD AND CRIMP | <u>300 POUNDS</u> |

WORK DESCRIPTION

- REMOVE RAIL FROM THE COLLAPSED ADIT
- DISPOSE OF ALL DEBRIS
- STRIP AND STOCKPILE 4 INCHES OF TOPSOIL FROM THE BORROW AREA. AREAS OVER MINE VOIDS, AND THE SUBSIDENCE AREAS
- EXCAVATE THE UNDERGROUND MINE VOIDS
- BACKFILL THE MINE VOIDS, EXCAVATIONS, AND SUBSIDENCE AREAS. USE STOCKPILE AND BORROW MATERIAL
- PLACE TOPSOIL FROM THE STOCKPILES OVER THE SUBSIDENCE AND BORROW AREAS
- REVEGETATE ALL DISTURBED AREAS

COAL MAINTENANCE

COAL CREEK SITE

| | |
|-----------------------|---|
| Date February 1993 | SPECTRUM ENGINEERING Mining and Civil Engineers Billings, Montana |
| Sheet No 3 of 9 | |

ADDITIONAL INFORMATION PERTAINING
TO THIS SITE MAY EXIST IN THE
DEPARTMENT OF STATE LANDS'
FILES OR AT SPECTRUM ENGINEERING'S
OFFICE. THIS MATERIAL IS AVAILABLE
FOR REVIEW BY ANY INTERESTED PARTY.

Vertical Datum Based On Interpolation Of
"SGS 1/2" Quadrangle WILLOW CROSSING, MT
Topography Prepared From Ground Survey
Conducted In 1949 By Spectrum Engineering
Using A Plane Table And Alidade This
Topography Is Of Reconnaissance Class
And Has Not Been Field Checked

ADDITIONAL INFORMATION PERTAINING TO THIS SITE MAY EXIST IN THE DEPARTMENT OF STATE LANDS' FILES OR AT SPECTRUM ENGINEERING'S OFFICE. THIS MATERIAL IS AVAILABLE FOR REVIEW BY ANY INTERESTED PARTY.

— 3500 — CONTOUR (1) → PICTURE NUMBER AND ORIENTATION

○ COAL SLACK SP 1 SUBSIDENCE PIT (SP NUMBER (B DEPTH))


— · — · — DRAINAGE < OPEN ADIT

LANDOWNER AND CONTACT
SECTION 3, T3S, R45E

GREAT NORTHERN PROPERTIES
ATTN: STEVEN SHIRLEY
1101 NORTH 27th STREET- Suite 201
BILLINGS, MT 59101
PHONE: (406) 248-4885



NOTICE

AN ABANDONED COAL MINE UNDERLIES THIS SITE
MANY POTENTIAL HAZARDS EXIST. THE EXTENT
OF THESE HAZARDS IS NOT FULLY KNOWN
CONTRACTORS AND OTHER PERSONS WORKING AT
THE SITE SHALL APPRISE THEMSELVES OF THE
CONDITIONS AND TAKE WHATEVER STEPS ARE
DEEMED NECESSARY TO INSURE SAFETY WHILE
PERFORMING THEIR DUTIES

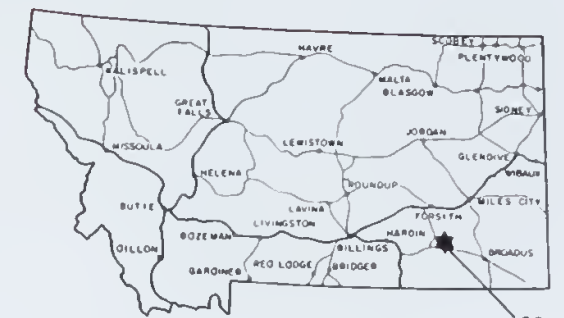

STATE LOCATION MAP

COAL CREEK
PROJECT
SITE

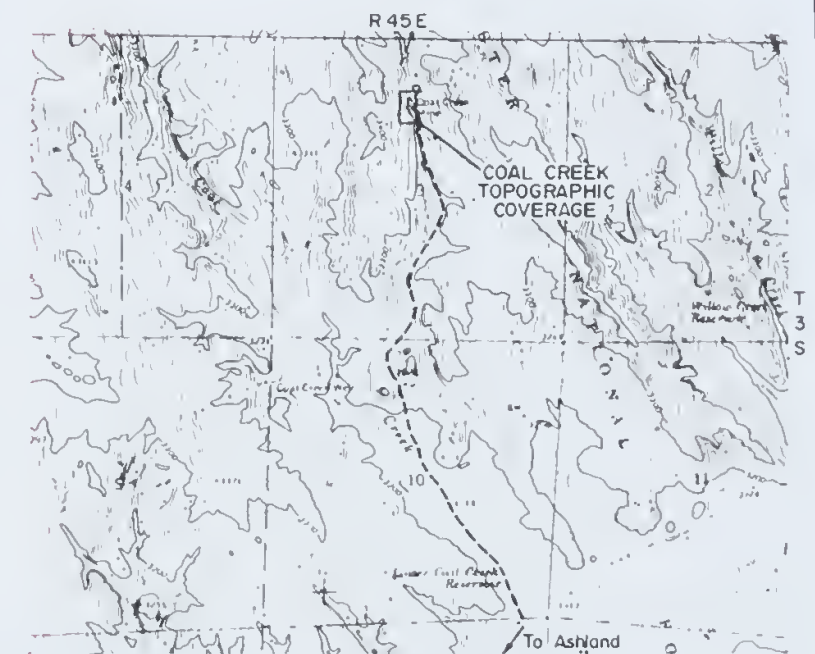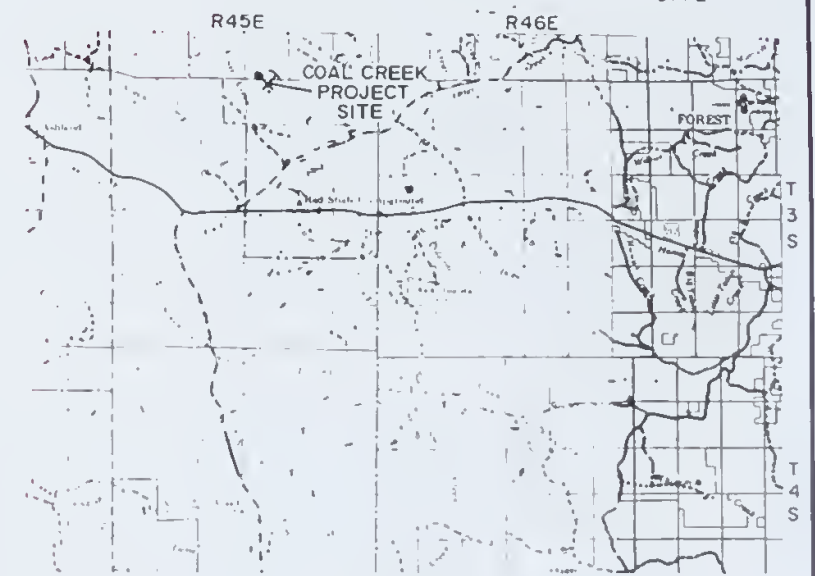

SITE LOCATION MAP
WILLOW CROSSING, MONTANA 7 1/2' USGS

SITE PLAN AND GENERAL LAYOUT

COAL CREEK SITE
SECTION 3, T3S, R45E
POWDER RIVER COUNTY, MONTANA




STATE OF MONTANA
DEPARTMENT OF STATE LANDS
ABANDONED MINE RECLAMATION BUREAU, RECLAMATION DIVISION

SPECTRUM ENGINEERING
Mining and Civil Engineers

1413 4th AVE NORTH
BILLINGS, MONTANA

DATE August 1990
DRAWN BY: DLO
APPROVED BY GWR
REVISIONS
NO DATE BY
SHEET NO 6 of 11

AS-BUILT DRAWING AND PHOTO INDEX

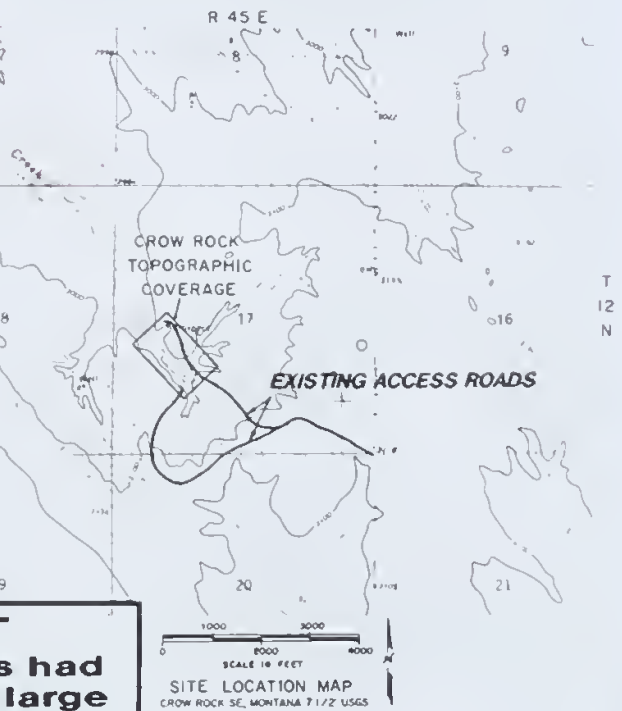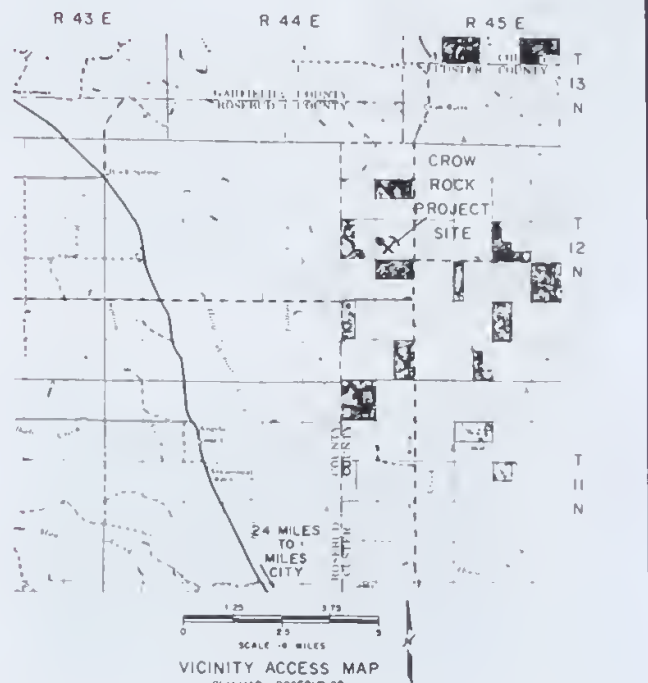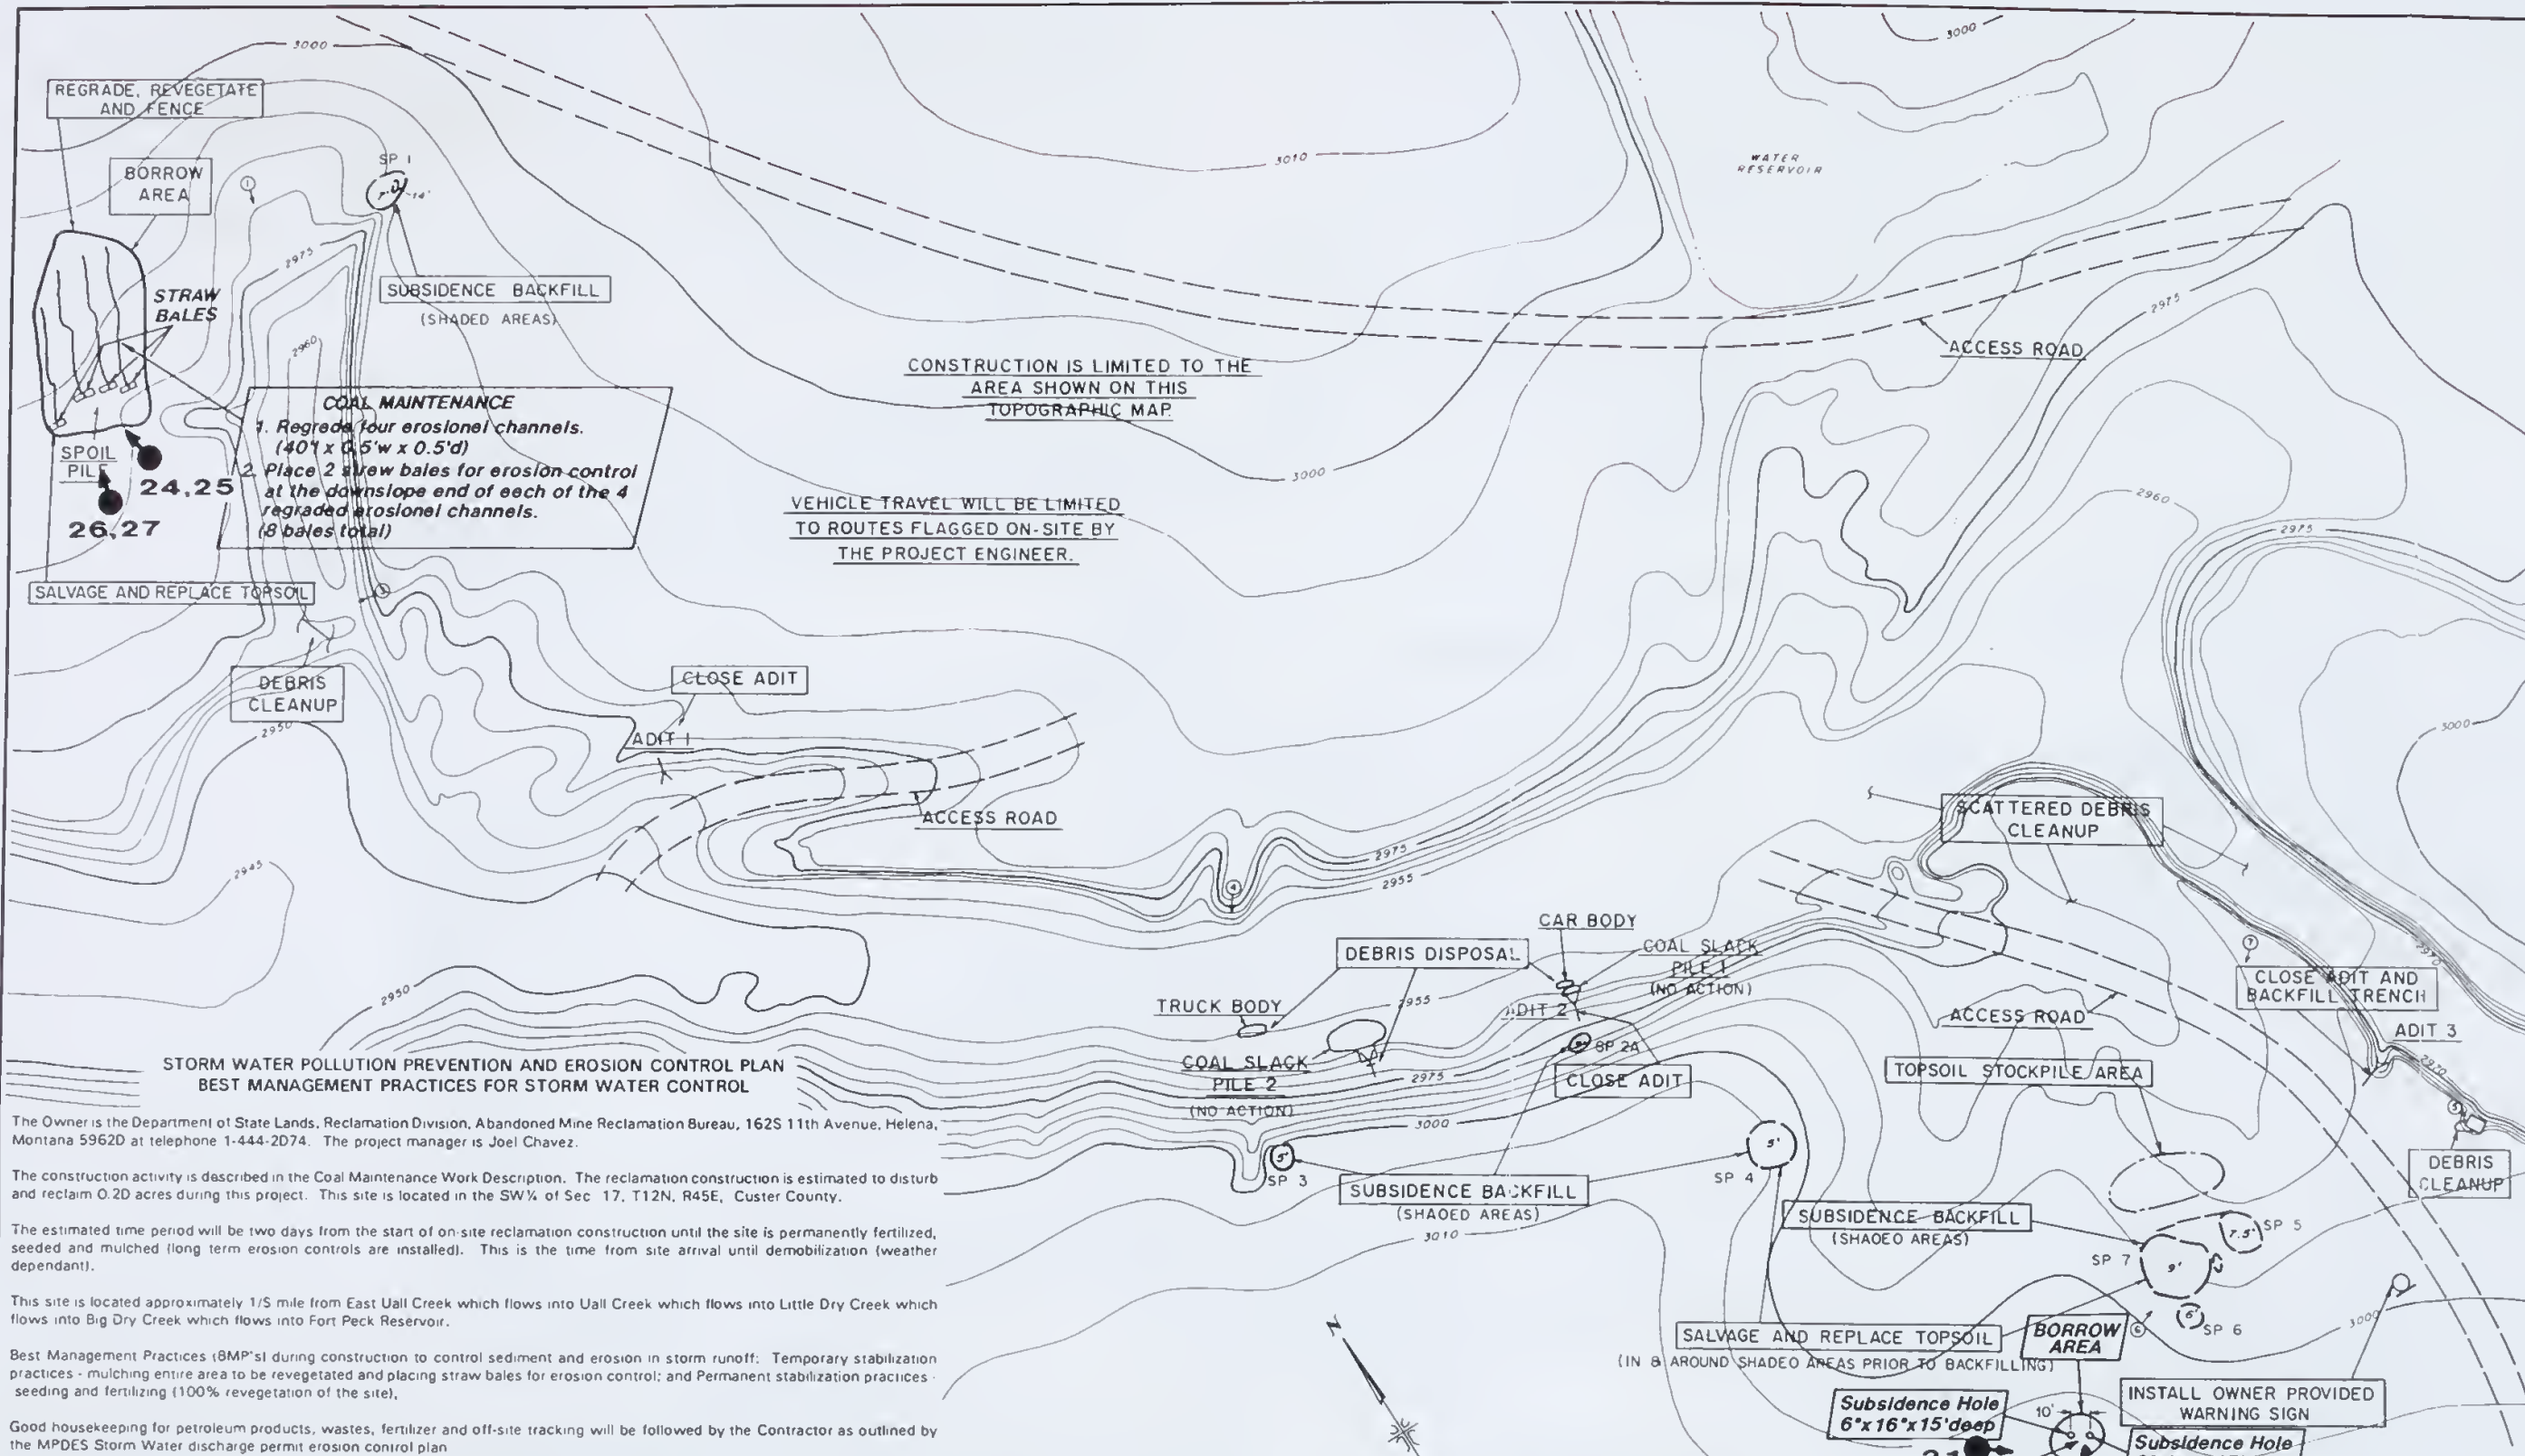

The Owner is the Department of State Lands, Reclamation Division, Abandoned Mine Reclamation Bureau, 162S 11th Avenue, Helena, Montana 5962D at telephone 1-444-2074. The project manager is Joel Chavez.

The construction activity is described in the Coal Maintenance Work Description. The reclamation construction is estimated to disturb and reclaim 0.20 acres during this project. This site is located in the SW 1/4 of Sec 17, T12N, R45E, Custer County.

The estimated time period will be two days from the start of on-site reclamation construction until the site is permanently fertilized, seeded and mulched (long term erosion controls are installed). This is the time from site arrival until demobilization (weather dependent).

This site is located approximately 1/5 mile from East Uall Creek which flows into Uall Creek which flows into Little Dry Creek which flows into Big Dry Creek which flows into Fort Peck Reservoir.

Best Management Practices (BMP's) during construction to control sediment and erosion in storm runoff: Temporary stabilization practices - mulching entire area to be revegetated and placing straw bales for erosion control; and Permanent stabilization practices - seeding and fertilizing (100% revegetation of the site).

Good housekeeping for petroleum products, wastes, fertilizer and off-site tracking will be followed by the Contractor as outlined by the MPDES Storm Water discharge permit erosion control plan.

| DESCRIPTION OF DISTURBANCE SITES | | | |
|----------------------------------|-------------------|--------------|--------------------------------|
| ITEM | DIMENSIONS (FEET) | DEPTH (FEET) | ESTIMATED VOLUME (CUBIC YARDS) |
| SP 1 | 14x20 | 8-14 | 33 VOID |
| SP 2A | 8x8.5 | 9 | 23 VOID |
| SP 3 | 18x25 | 5 | 44 VOID |
| SP 4 | 26x31 | 5 | 78 VOID |
| SP 5 | 14x27 | 7 | 51 VOID |
| SP 6 | 13x17 | 7 | 30 VOID |
| SP 7 | 35x35 | 9 | 175 VOID |
| COAL SLACK PILE 1 | 5x10 | 2 | NO ACTION |
| COAL SLACK PILE 2 | 5x30 | 4 | NO ACTION |
| SPOIL PILE | 65x10 | 0 to 6 | — |
| ADIT 1 | 31x6 | 15 | 15 VOID |
| ADIT 2 | 31x4 | 5 | 5 VOID |
| ADIT 3 8 TRENCH | 15x16 | 6 | 53 VOID |
| REVEGETATION | 0.5 ACRES | | |
| FARM FENCE | | | |
| Type F-41 | 270 LINEAR FEET | | |
| Single Panel | 1 EACH | | |
| Double Panel | 4 EACH | | |
| Gate - Type G-2 | 16 LINEAR FEET | | |

LANDOWNER - SECTION 17

GREAT NORTHERN PROPERTIES
ATTN: STEVE SHIRLEY
1101 NORTH 27th STREET-Suite 201
BILLINGS, MT 59101
PHONE: (406) 248-4885

Vertical Datum Based On Interpolation To 74
Quadrangle CROW ROCK SE, MT Topography Prepared
From Ground Survey Conducted August 27, 1986 By
Spectrum Engineering Using A Plane Table And Alidade
This Topography is Of Reconnaissance Class And Has Not
Been Field Checked

ARCHAEOLOGICAL NOTICE

ANY KNOWN ARCHAEOLOGICAL MATERIALS NEAR THE CONSTRUCTION AREAS WILL BE MARKED BY THE OWNER AT NO TIME SHALL THESE ARCHAEOLOGICAL MATERIALS BE DISTURBED WITHOUT THE WRITTEN PERMISSION FROM THE OWNER

REDUCED PRINTS ARE APPROX.
1/2 ORIGINAL SCALE

ADDITIONAL INFORMATION PERTAINING TO THIS SITE MAY EXIST IN THE DEPARTMENT OF STATE LANDS' FILES OR AT SPECTRUM ENGINEERING'S OFFICE. THIS MATERIAL IS AVAILABLE FOR REVIEW BY ANY INTERESTED PARTY.

WORK DESCRIPTION
BACKFILL SUBSIDENCE PITS AND SEAL ADITS WITH MATERIAL FROM SPOIL PILE AREA. REGRADE THE BORROW (SPOIL) AREA TO PROVIDE UNIFORM TRANSITIONS WITH EXISTING CONTOURS. HAUL AWAY CAR AND TRUCK BODIES AND DISPOSE OF ALL DEBRIS. ALL DISTURBED AREAS WILL BE SEED, FERTILIZED AND MULCHED. ADDITIONAL SPOIL PILE WORK DESCRIPTIONS ARE LOCATED IN THE SPECIAL PROVISIONS.

COAL MAINTENANCE
1. Salvage and replace 1' of cover soil from borrow area (estimate 3 cubic yards). Borrow area is adjacent to the subsidence holes.
2. Excavate the two subsidence holes (3' dia. x 17' deep & 6' x 16' x 15' deep) down a minimum of five feet. Then backfill with 2 cubic yards of borrow.
3. Fertilize, seed and mulch backfilled subsidence holes, borrow area, four erosional channels in the north area & all other disturbed areas—0.2 acres.

CONSTRUCTION PHOTOS

NOTICE
AN ABANDONED COAL MINE UNDERLIES THIS SITE. MANY POTENTIAL HAZARDS EXIST. THE EXTENT OF THESE HAZARDS IS NOT FULLY KNOWN. CONTRACTORS AND OTHER PERSONS WORKING AT THE SITE SHALL APPRISE THEMSELVES OF THE CONDITIONS AND TAKE WHATEVER STEPS ARE DEEMED NECESSARY TO INSURE SAFETY WHILE PERFORMING THEIR DUTIES.


AS-BUILT
Two small holes had turned into one large 12'x20'x8'deep hole.

COAL MAINTENANCE
CROW ROCK SITE
SECTION 17, T12N, R45E
CUSTER COUNTY, MONTANA
Date: February 1993
Sheet No. 9 of 9
SPECTRUM ENGINEERING
Mining and Civil Engineers
Billings, Montana


SITE PLAN AND GENERAL LAYOUT
CROW ROCK SITE
SECTION 17, T12N, R45E
CUSTER COUNTY, MONTANA
STATE OF MONTANA
DEPARTMENT OF STATE LANDS
ABANDONED MINE RECLAMATION BUREAU, RECLAMATION DIVISION
DATE: 12-19-86
DRAWN BY: LNR
CHECKED BY: JLC
APPROVED BY: JLC
NO. 814
REVISIONS BY: JLC
DATE: 2/97
BY: DLO
SHEET NO. 1 of 2
SPECTRUM ENGINEERING
Mining and Civil Engineers
1413 41A AVE NORTH
BILLINGS, MONTANA



AS-BUILT DRAWING AND PHOTO INDEX

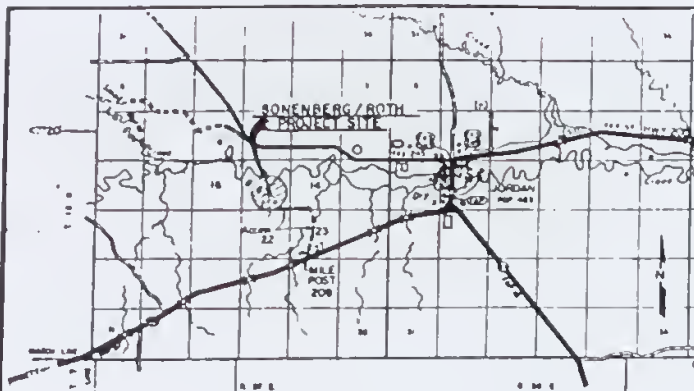

- COAL MAINTENANCE**
1. Salvage 1' cover soil from the borrow area and subsidence (estimate 3 cubic yards).
 2. Backfill subsidence (8'x5'x7' deep) with borrow material.
 3. Place 1' of cover soil over backfilled subsidence and borrow area.
 4. Regrade erosional channel (60' long x 1' wide x 2' deep).
 5. Fertilize, seed and mulch all disturbed areas (estimate 0.10 acres).
 6. Place 4 straw bales for erosion control at the down slope end of the reggraded erosional channel.

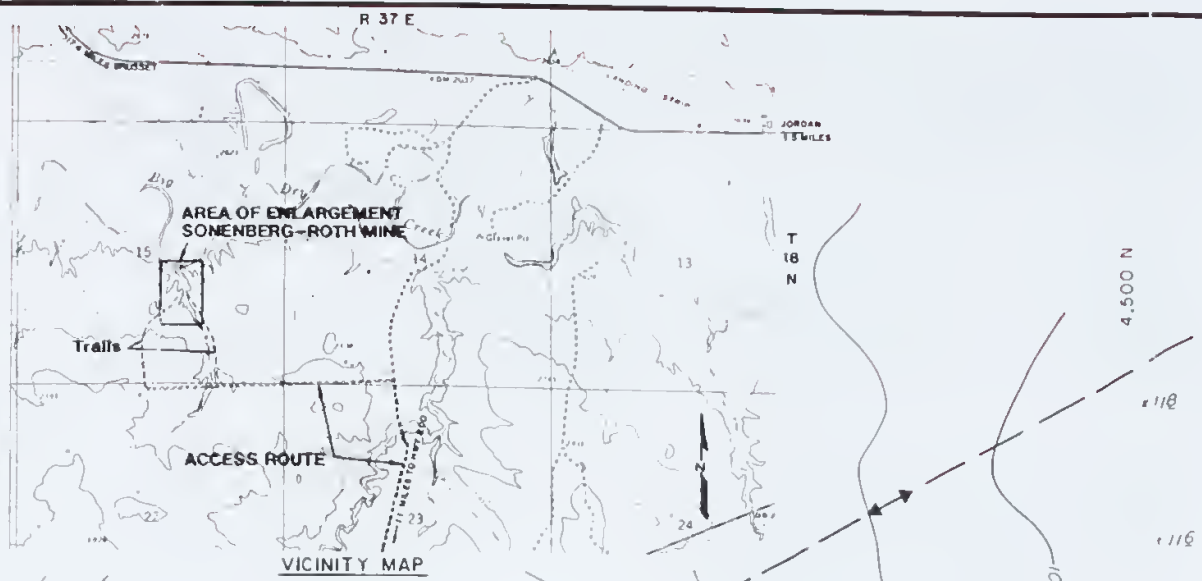


| SONENBERG / ROTH MINE ESTIMATED QUANTITIES | | |
|---|-----------|--|
| ITEM DESCRIPTION | UNITS | |
| BANK CAVING | 2 HRS | |
| SALVAGE AND REPLACE TOPSOIL | 175 CY | |
| CLOSE MINE OPENING (ADITS) | 3 Eo | |
| WASTE PILE DISPOSAL | 220 CY | |
| SUBSIDIENCE GRADING | 40 CY | |
| SUBSIDIENCE BACKFILL | 120 CY | |
| PROVIDE WATER | | |
| COMPACTION | 12.2 MGAL | |
| DUST CONTROL | 1.8 MGAL | |
| FERTILIZE, SEED, & MULCH | | |
| SUBSIDIENCE GRADING | 0.04 AC | |
| SUBSIDIENCE BACKFILL | 0.03 AC | |
| TOPSOIL STOCKPILE | 0.03 AC | |
| UPSTREAM ADIT CLOSURE | 0.04 AC | |
| ACCESS ROUTES (EST 360 LF) | 1.61 AC | |
| WASTE PILE DISPOSAL | 0.08 AC | |
| MATERIAL DISPOSAL AREA | 0.08 AC | |
| OWNER PROVIDED SIGN | 2 Eo | |

QUANTITY BASED ON ESTIMATED RATE OF 19.5 GAL/CY FOR DUST CONTROL.

Assumptions for Estimating:
In-Situ Moisture Content = 13%
Ultimate Moisture Content = 13%
Material Density = 1.25 Tons/Cu. Ft.

QUANTITY REQUIRED FOR DUST CONTROL ASSUMED TO BE 1% OF AMOUNT REQUIRED FOR COMPACTION.

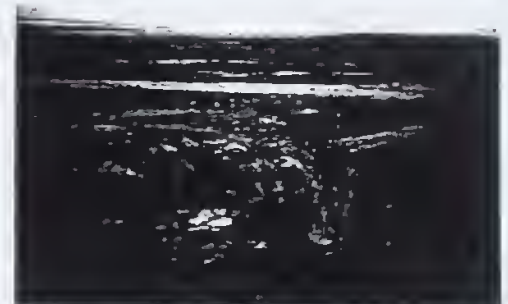

PICTURE 1 IS A HELICOPTER VIEW OF SUBSIDIENCE HOLE AND EROSIONAL CHANNEL LOOKING EAST.

ARCHAEOLOGICAL NOTICE

ANY KNOWN ARCHAEOLOGICAL MATERIALS NEAR THE CONSTRUCTION AREAS WILL BE MARKED BY THE OWNER AT NO TIME SHALL THESE ARCHAEOLOGICAL MATERIALS BE DISTURBED WITHOUT THE WRITTEN PERMISSION FROM THE OWNER

ADDITIONAL INFORMATION PERTAINING TO THESE SITES MAY EXIST IN THE DEPARTMENT OF STATE LANDS' FILES OR AT SPECTRUM ENGINEERING'S OFFICE. THIS MATERIAL IS AVAILABLE FOR REVIEW BY ANY INTERESTED PARTY.

| NO. | NORTH | EAST | ELEV |
|------|----------|-----------|---------|
| C.P. | 5,000.00 | 10,000.00 | 1000.00 |
| 1 | 5,549.06 | 10,155.49 | 990.90 |
| 2 | 5,143.47 | 9,761.54 | 999.02 |
| 3 | 4,751.73 | 9,583.02 | 1009.58 |
| 4 | 4,493.18 | 9,885.07 | 1012.14 |
| 5 | 4,698.84 | 10,336.83 | 1006.58 |

NOTICE

AN ABANDONED COAL MINE UNDERLIES THIS SITE. MANY POTENTIAL HAZARDS EXIST. THE EXTENT OF THESE HAZARDS IS NOT FULLY KNOWN. CONTRACTORS AND OTHER PERSONS WORKING AT THE SITE SHALL APPRISE THEMSELVES OF THE CONDITIONS AND TAKE WHATEVER STEPS ARE DEEMED NECESSARY TO INSURE SAFETY WHILE PERFORMING THEIR DUTIES.



ADDITIONAL INFORMATION PERTAINING TO THIS SITE MAY EXIST IN THE DEPARTMENT OF STATE LANDS' FILES OR AT THE OFFICES OF THEIR ENGINEERING REPRESENTATIVE AND SUCH MATERIAL IS AVAILABLE FOR REVIEW BY THOSE INTERESTED IN DOING SO.

Geodetic Grid North Based On Magnetic Bearing
Vertical Datum Based On Assumed Elevation 1000.00' At C.P. - Ground Control Surveys Conducted August 10, 1984 By Montana Department of State Lands.

Topography Prepared From Hasselblad Camera, 50 MM Distagon Lens, Aerial Photography, 1"=725', August 10, 1984, With Lens Correction Applied. This Topography Has Not Been Field Checked.

Associated Surveys, Inc., Billings, Montana.

- LEGEND**
- PAVED ROAD
 - IMPROVED ROAD
 - TRAIL
 - BRIDGE
 - CATTLE GUARD
 - CULVERT
 - FENCE
 - RAILROAD
 - POWER POLE
 - TREES
 - DRAINAGE
 - POND
 - SWAMP
 - INDEX CONTOUR
 - INTERMEDIATE CONTOUR
 - DEPRESSION CONTOUR
 - BUILDING
 - DEPTH OF SUBSIDIENCE

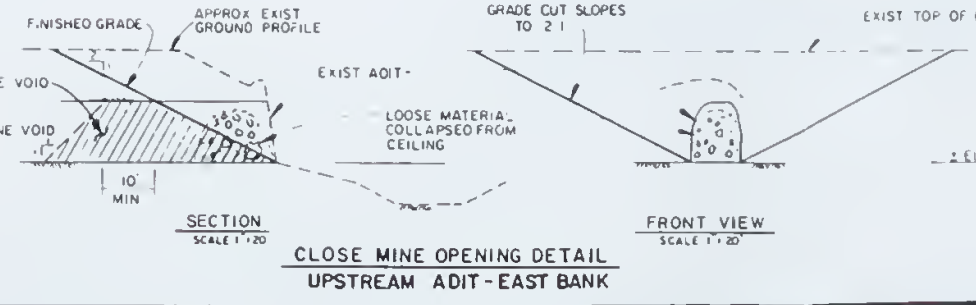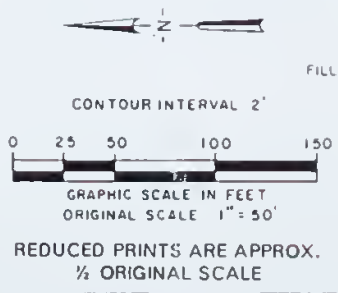

**STORM WATER POLLUTION PREVENTION AND EROSION CONTROL PLAN
BEST MANAGEMENT PRACTICES
FOR STORM WATER CONTROL**

The Owner is the Department of State Lands, Reclamation Division, Abandoned Mine Reclamation Bureau, 1625 11th Avenue, Helena, Montana 59620 at telephone 1 444 2074. The project manager is Joel Chavez.

The construction activity is described in the Coal Maintenance Work Description. The reclamation construction is estimated to disturb and reclaim 0.10 acres during this project. This site is located in the SE 1/4 of Sec 15, T18N, R37E, Garfield County.

The estimated time period will be two days from the start of on-site reclamation construction until the site is permanently stabilized seeded and mulched (long term erosion controls are installed). This is the time from site arrival until demobilization (weather dependent).

Best Management Practices (BMP's) during construction to control sediment and erosion in storm runoff: Temporary stabilization practices - mulching entire area to be revegetated and placing straw bales for erosion control; and Permanent stabilization practices - seeding and fertilizing (100% revegetation of the site).

Good housekeeping for petroleum products, wastes, fertilizer and off-site tracking will be followed by the contractor as outlined by the MPOES Storm Water discharge permit erosion control plan.

LANDOWNER

ALL SEC 15, T18N, R37E
COLEMAN C & VIRGINIA LOU MURNION
PO BOX 13
JORDON, MT 59337
PH (406) 557-2251

| COAL MAINTENANCE | |
|--|---|
| SONENBERG-ROTH SITE | |
| SECTION 15, T18N, R37E GARFIELD COUNTY, MONTANA | |
| Date: April 1993 | SPECTRUM ENGINEERING |
| Sheet No: 5 of 9 | Mining and Civil Engineers Billings, Montana |

STATE OF MONTANA
DEPT OF STATE LANDS
RECLAMATION DIVISION




SONENBERG / ROTH
S.E. 1/4, SEC 15, T18N, R37E
GARFIELD COUNTY, MONTANA

ASSOCIATED SURVEYS INC
land & aerial
BILLINGS, MONTANA

L. C. Hanson Co.
CONSULTING CIVIL SANITARY MUNICIPAL AND STRUCTURAL ENGINEERS
HELENA, MONTANA

SONENBERG/ROTH MINE-RECLAMATION PLAN
SITE PLAN AND GENERAL LAYOUT

CREATED BY: S M Y
APPROVED BY: [Signature]
DATE: 4/11/93
SCALE: 1" = 50'
SHEET NO: 2
OF: 5
85-10-14

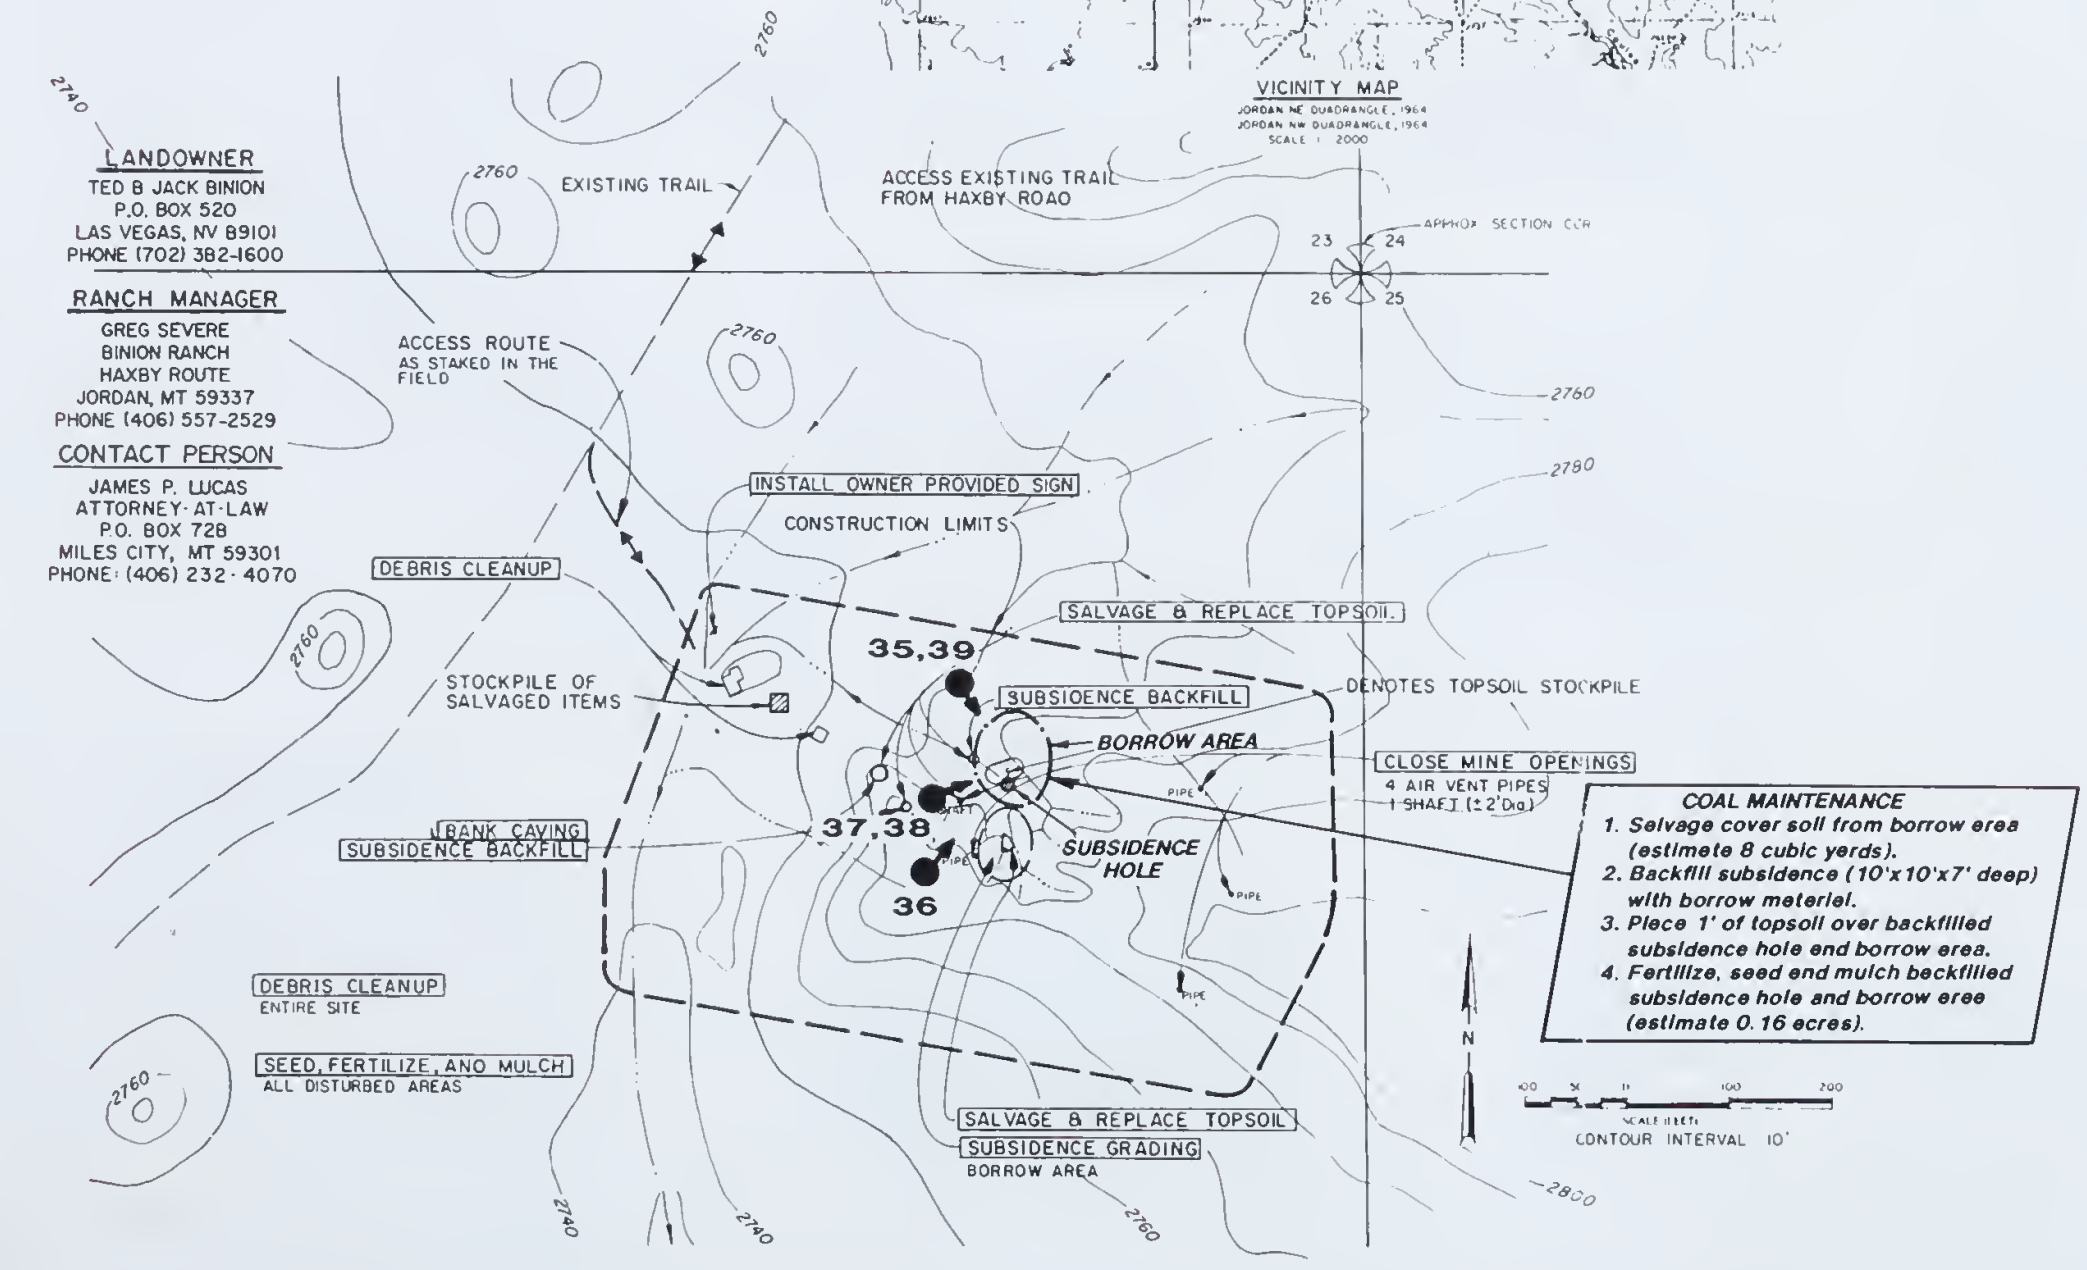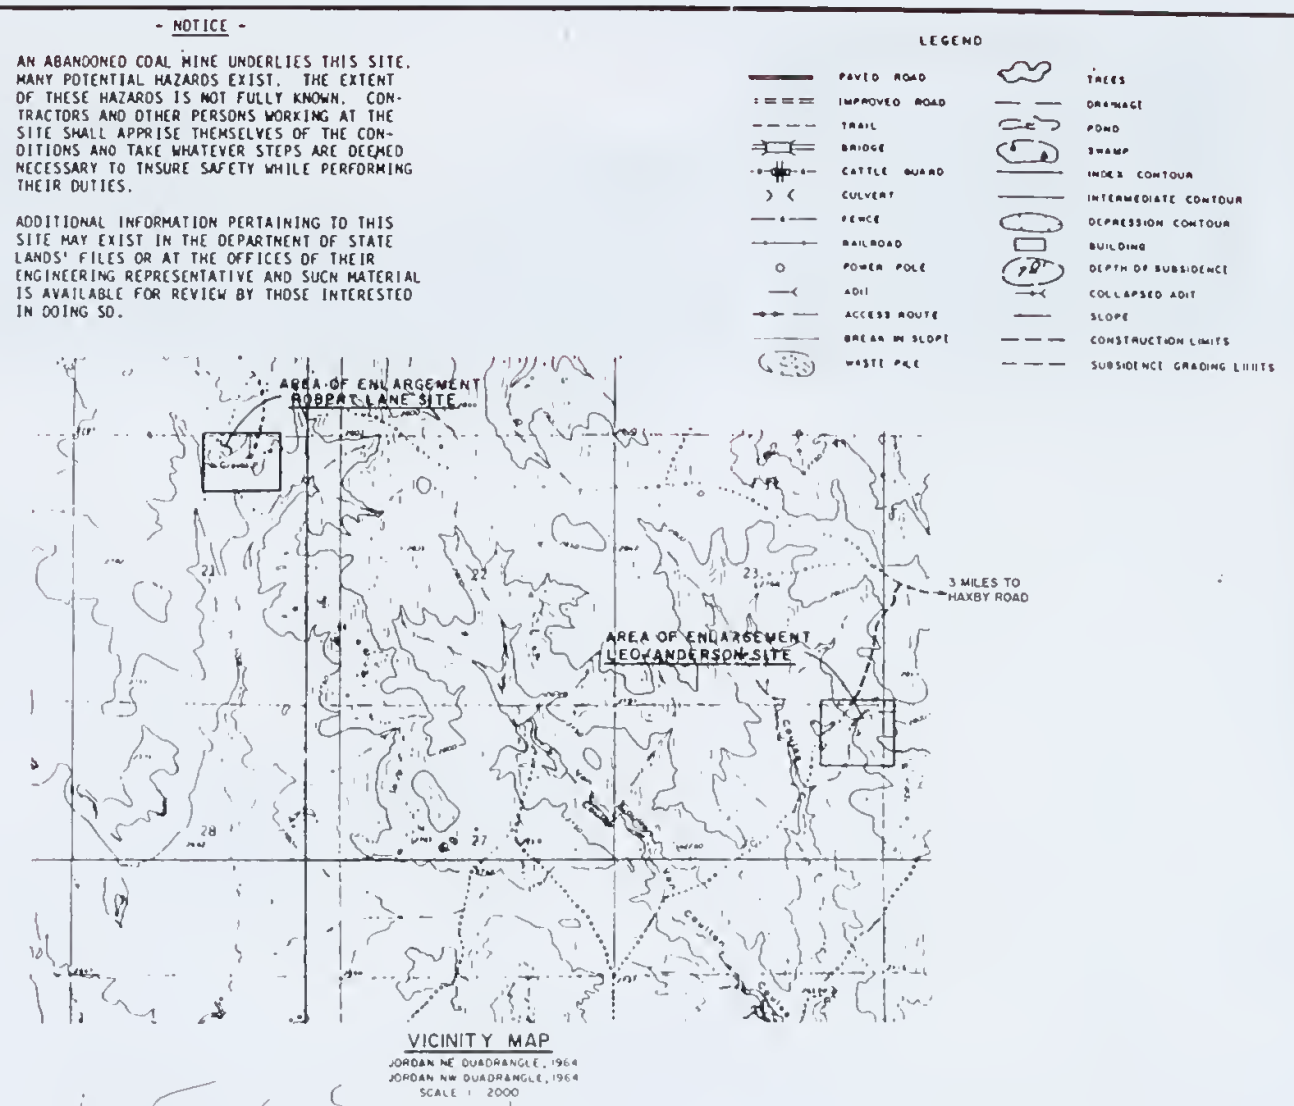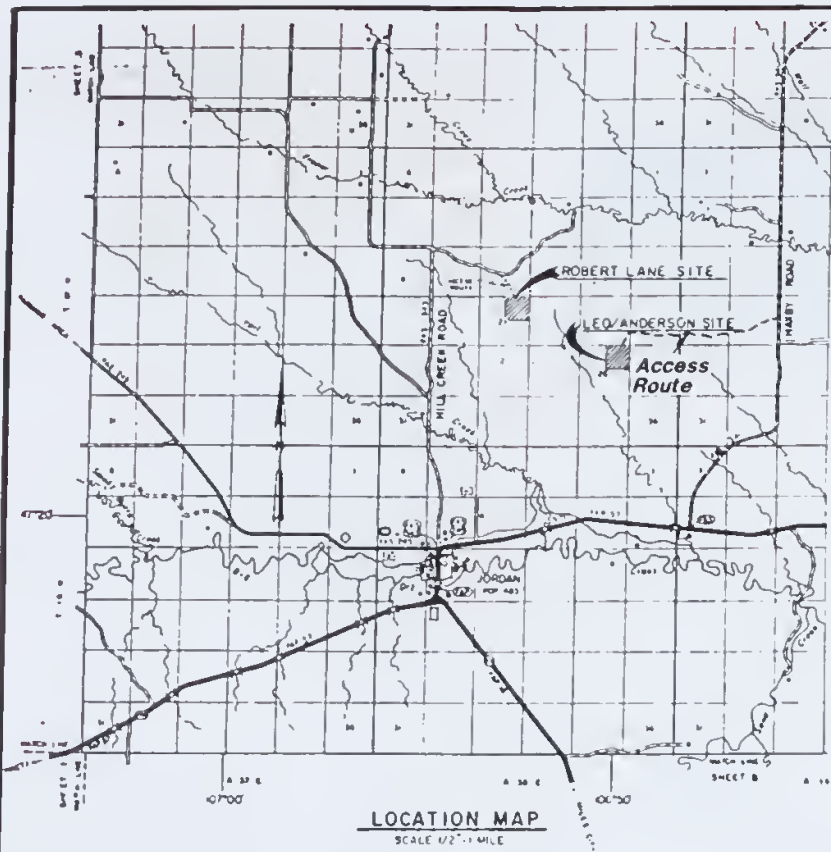

LEO/ANDERSON SITE

CONSTRUCTION PHOTOS

REOUCEO PRINTS ARE APPROX.
1/2 ORIGINAL SCALE

| LEO/ANDERSON SITE ESTIMATED QUANTITIES | |
|---|---------|
| ITEM DESCRIPTION | UNITS |
| SALVAGE AND REPLACE TOPSOIL | 100 CY |
| BANK CAVING | 2 HRS |
| CLOSE MINE OPENING | |
| AIR VENT PIPE | 2 EA |
| SHAFT | 1 EA |
| SUBSIDENCE BACKFILL | 50 CY |
| SUBSIDENCE GRADING | 20 CY |
| PROVIDE WATER * | |
| COMPACTION | 17 MGAL |
| DUST CONTROL | 03 MGAL |
| SEED, FERTILIZE, AND MULCH | 01 AC |
| OWNER PROVIDED SIGN | 1 EA |

| ROBERT LANE SITE ESTIMATED QUANTITIES | |
|--|---------|
| ITEM DESCRIPTION | UNITS |
| SALVAGE AND REPLACE TOPSOIL | 40 CY |
| CLOSE MINE OPENING - ADIT | 1 EA |
| SUBSIDENCE BACKFILL | 70 CY |
| WASTE PILE DISPOSAL | 60 CY |
| WATER FLOODING | 70 MGAL |
| PROVIDE WATER * | 30 MGAL |
| INTERCEPTOR DITCH | 100 LF |
| SEED, FERTILIZE, AND MULCH | 03 AC |
| OWNER PROVIDED SIGN | 1 EA |

* QUANTITY BASED ON ESTIMATED RATE OF 19.5 GAL/C.Y. FOR COMPACTION.

* QUANTITY BASED ON ESTIMATED RATE OF 19.5 GAL/C.Y. FOR COMPACTION.

Assumptions for Estimating

Assumptions for Estimating

In-Situ Moisture Content - 8%

In-Situ Moisture Content - 8%

Optimum Moisture Content - 13%

Optimum Moisture Content - 13%

Material Density - 120 Lbs/Cu. Ft.

Material Density - 120 Lbs/Cu. Ft.

QUANTITY REQUIRED FOR DUST CONTROL ASSUMED TO BE 1% OF AMOUNT REQUIRED FOR COMPACTION.

QUANTITY REQUIRED FOR DUST CONTROL ASSUMED TO BE 1% OF AMOUNT REQUIRED FOR COMPACTION.

STORM WATER POLLUTION PREVENTION AND EROSION CONTROL PLAN BEST MANAGEMENT PRACTICES FOR STORM WATER CONTROL

The Owner is the Department of State Lands, Reclamation Division, Abandoned Mine Reclamation Bureau, 1625 11th Avenue, Helena, Montana 59620 at telephone 1-444-2074. The project manager is Joel Chavez.

The construction activity is described in the Coal Maintenance Work Description. The reclamation construction is estimated to disturb and reclaim 0.16 acres during this project. This site is located in the NE1/4NE1/4 of Sec. 26, T19N, R38E, Garfield County.

The estimated time period will be one day from the start of on-site reclamation construction until the site is permanently fertilized, seeded and mulched (long term erosion controls are installed). This is the time from site arrival until demobilization (weather dependent).

This site is located approximately 1/5 mile from Van Coulten Coulee which flows into Big Dry Creek which flows into Fort Peck Reservoir.

Best Management Practices (BMP's) during construction to control sediment and erosion in storm runoff. Temporary stabilization practices - mulching entire area to be revegetated; and Permanent stabilization practices - seeding and fertilizing (100% revegetation of the site).

Good housekeeping for petroleum products, wastes, fertilizer and off-site tracking will be followed by the contractor as outlined by the MPDES Storm Water discharge permit erosion control plan.



ARCHAEOLOGICAL NOTICE

ANY KNOWN ARCHAEOLOGICAL MATERIALS NEAR THE CONSTRUCTION AREAS WILL BE MARKED BY THE OWNER AT NO TIME SHALL THESE ARCHAEOLOGICAL MATERIALS BE DISTURBED WITHOUT THE WRITTEN PERMISSION FROM THE OWNER.

ADDITIONAL INFORMATION PERTAINING TO THIS SITE MAY EXIST IN THE DEPARTMENT OF STATE LANDS' FILES OR AT SPECTRUM ENGINEERING'S OFFICE. THIS MATERIAL IS AVAILABLE FOR REVIEW BY ANY INTERESTED PARTY.

COAL MAINTENANCE
LEO/ANDERSON SITE
SECTION 26, T19N, R38E
GARFIELD COUNTY, MONTANA

Date: April 1993
Sheet No: 6 of 9
SPECTRUM ENGINEERING
Mining and Civil Engineers
Billings, Montana

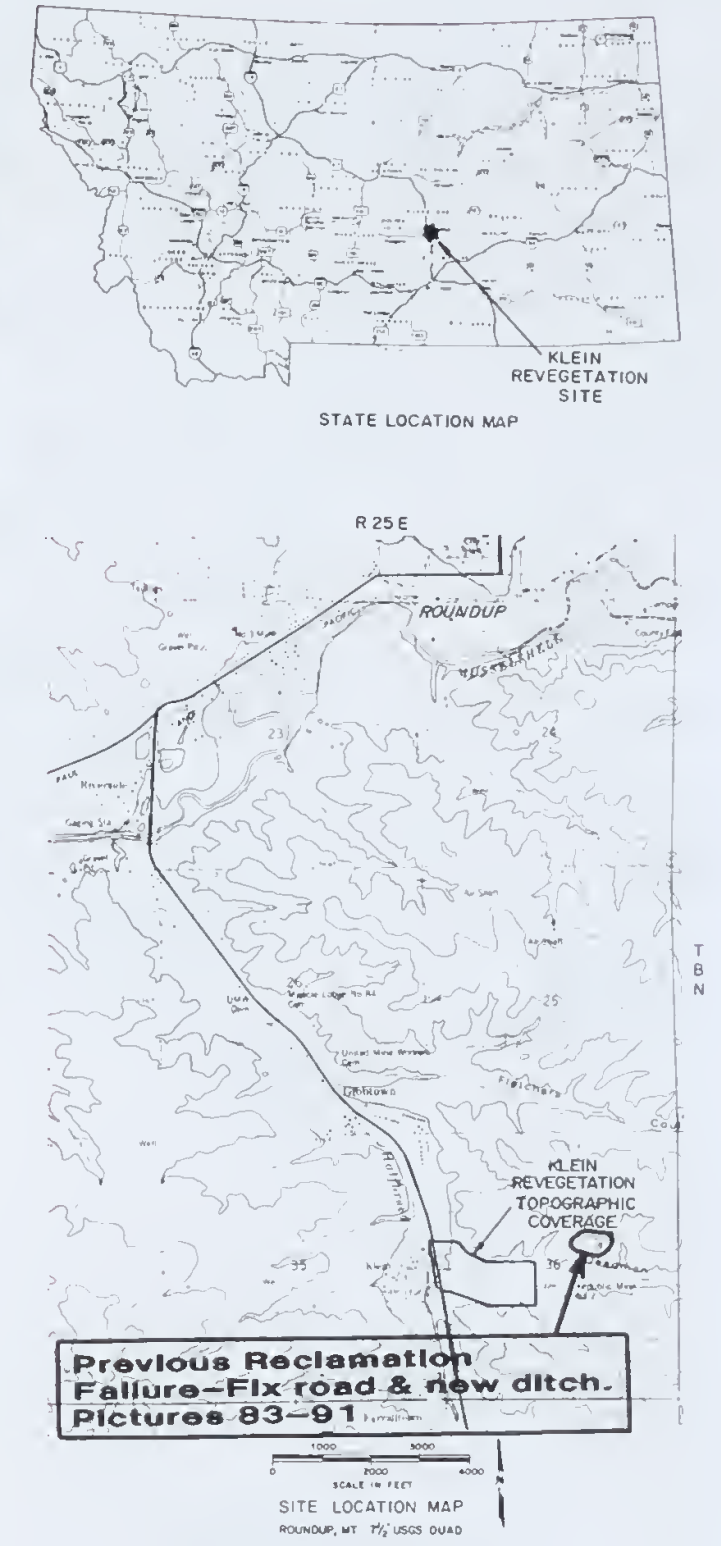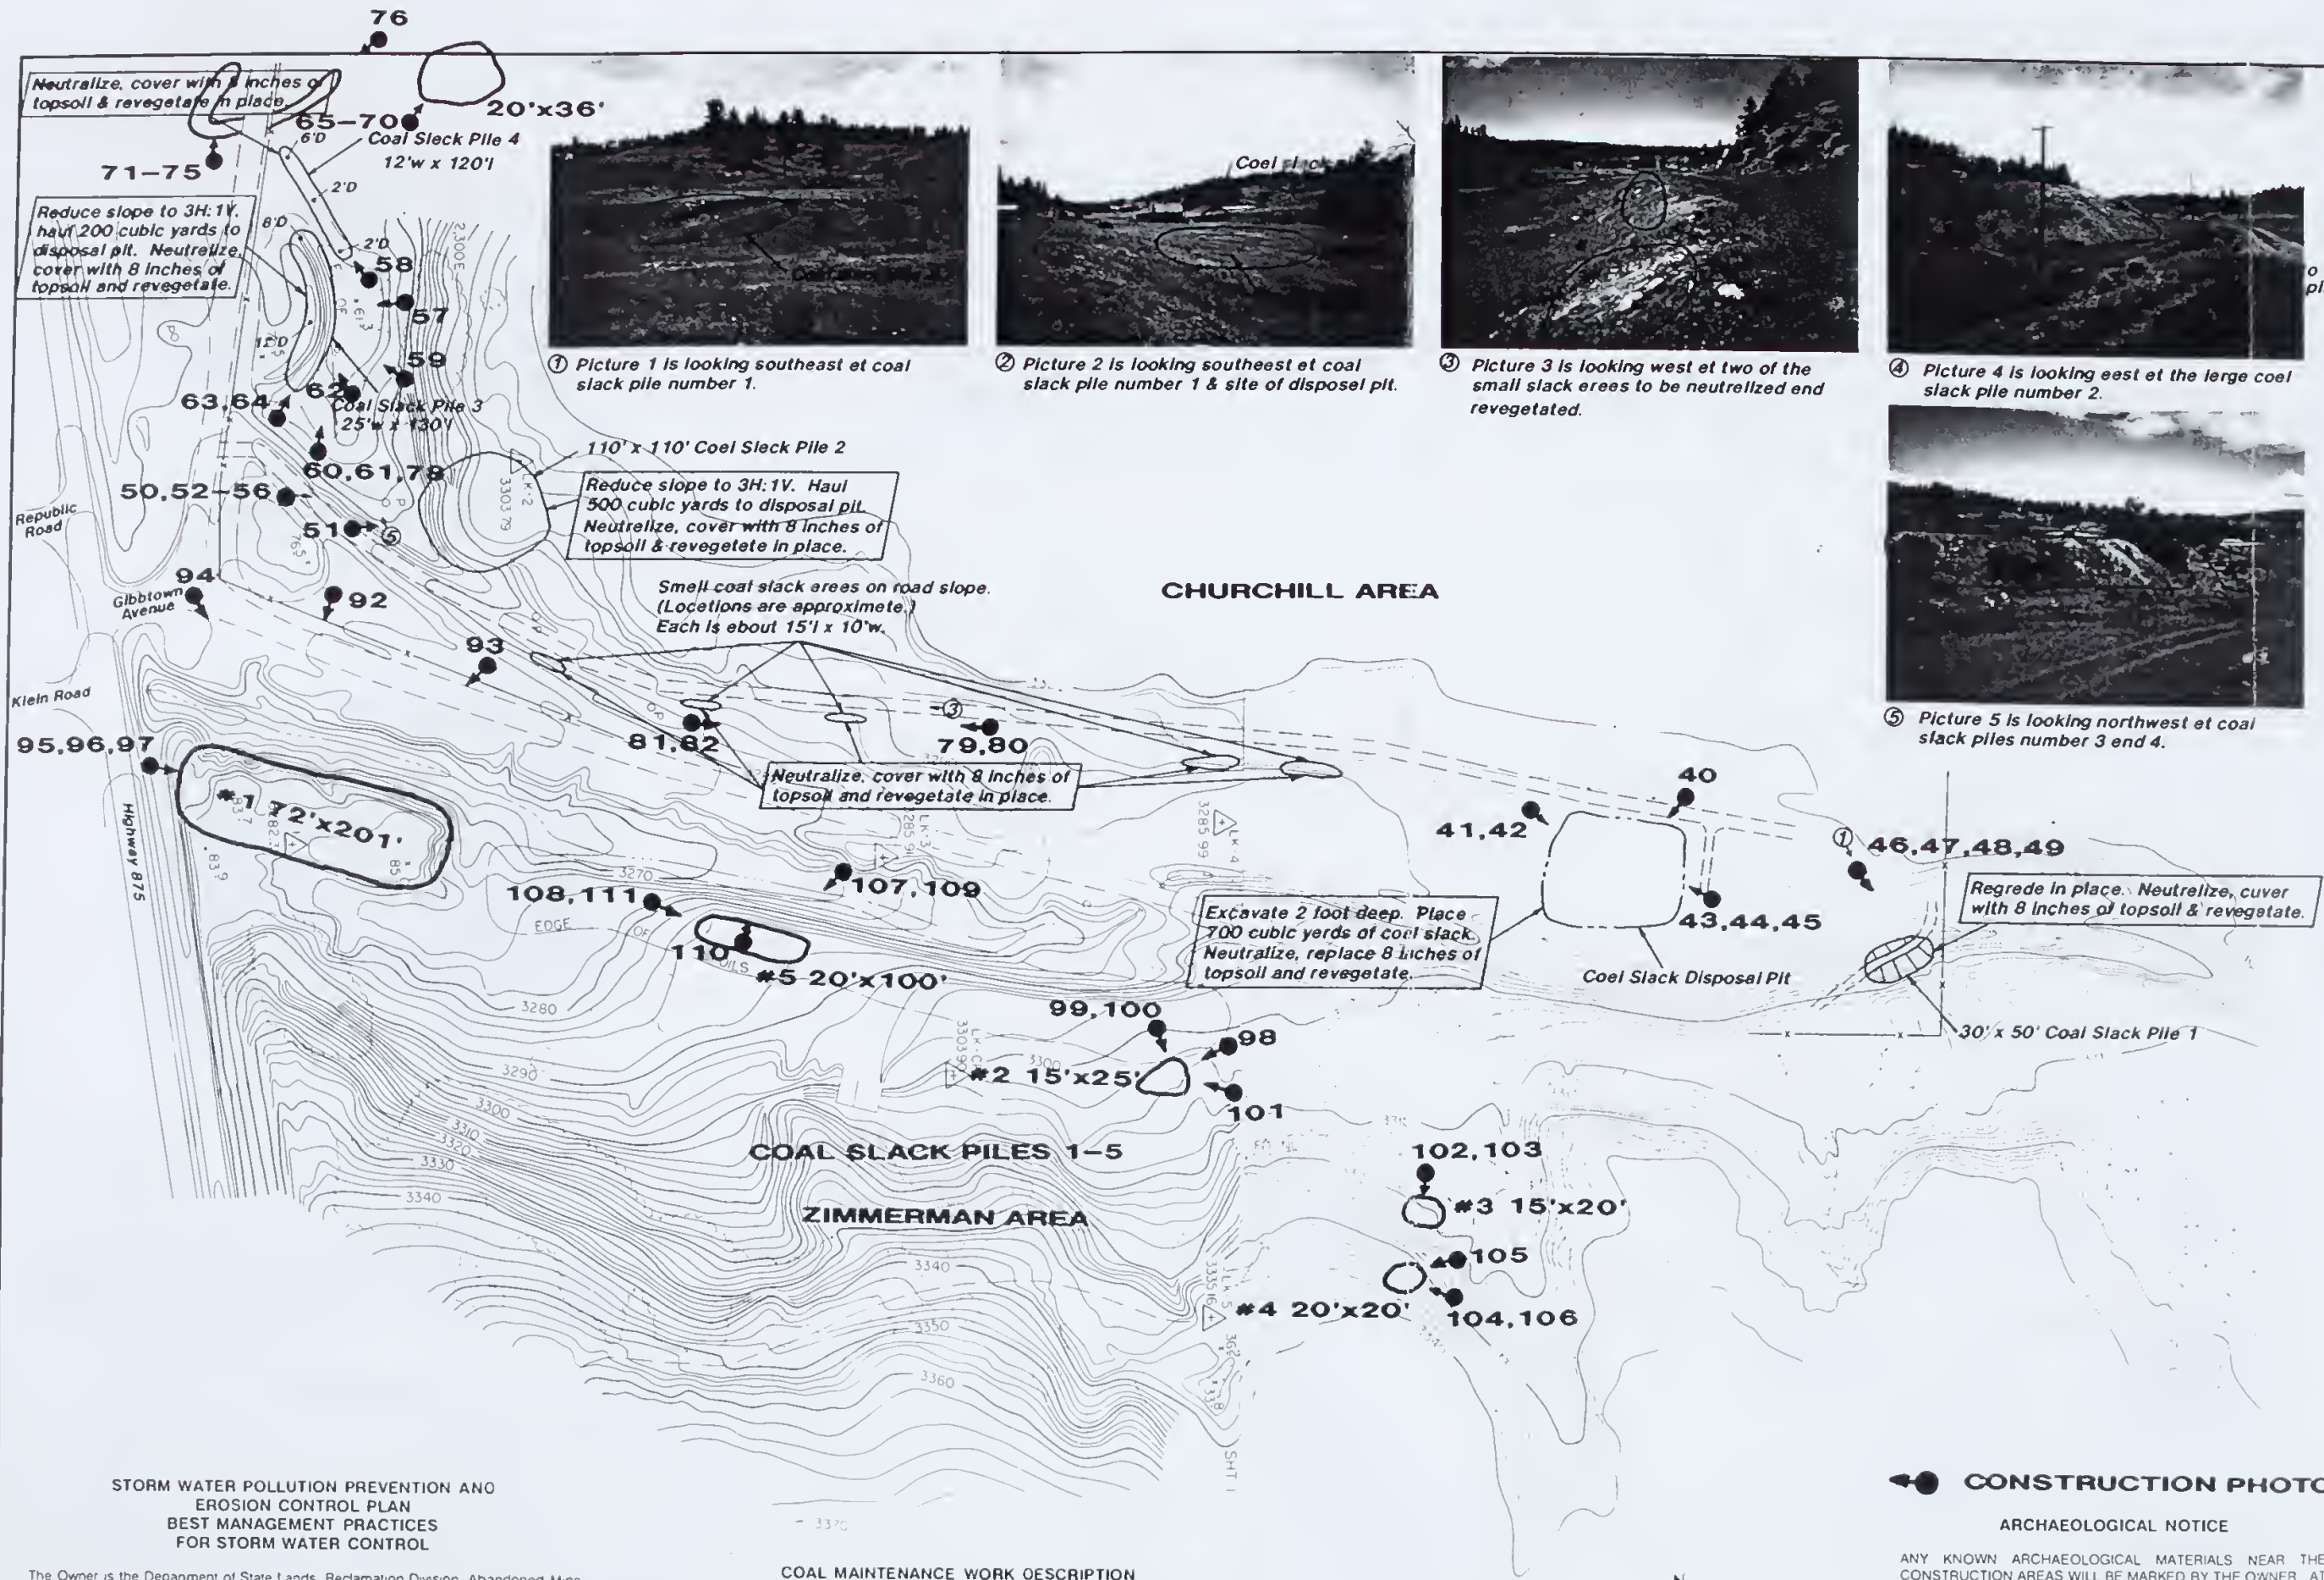

**STORM WATER POLLUTION PREVENTION AND EROSION CONTROL PLAN
BEST MANAGEMENT PRACTICES
FOR STORM WATER CONTROL**

The Owner is the Department of State Lands, Reclamation Division, Abandoned Mine Reclamation Bureau, 1625 11th Avenue, Helena, Montana 59620 at telephone 1-444-2074. The project manager is Joel Chavez.

The construction activity is described in the Coal Maintenance Work Description. The reclamation construction is estimated to disturb and reclaim 0.80 acres during this project. This site is located in the N $\frac{1}{2}$ SW $\frac{1}{4}$ and the S $\frac{1}{2}$ NW $\frac{1}{4}$ of Section 36, T8N, R25E, Musselshell County.

The estimated time period will be four days from the start of on-site reclamation construction until the site is permanently fertilized seeded and mulched (long term erosion controls are installed). This is the time from site arrival until demobilization (weather dependant).

This site is located approximately 500 feet from Half Breed Creek which flows into the Musselshell River.

Best Management Practices (BMPs) during construction to control sediment and erosion in storm runoff: Temporary stabilization practices - mulching entire area to be revegetated and Permanent stabilization practices - seeding and fertilizing (100% revegetation of the site).

Good housekeeping for petroleum products, wastes, fertilizer and off site tracking will be followed by the contractor as outlined by the MPDES Storm Water discharge permit erosion control plan.

COAL MAINTENANCE WORK DESCRIPTION

1. EXCAVATE COAL SLACK DISPOSAL PIT (100'x120') TO 2 FOOT DEPTH AND STOCKPILE TOPSOIL ADJACENT TO IT (900 CY)
2. REDUCE THE SLOPES ON COAL SLACK PILE 2 (500 CY) AND PILE 3 (200 CY) AND BURY MATERIAL IN THE DISPOSAL PIT
3. NEUTRALIZE THE FOUR COAL SLACK PILES, FIVE SMALL SLACK AREAS, AND THE DISPOSAL PIT WITH 11.2 TONS OF LIME (0.80 ACRES x 14 TONS PER ACRE)
4. RESPREAD STOCKPILED TOPSOIL OVER ALL NEUTRALIZED AREAS (COAL SLACK PILES, COAL SLACK AREAS AND DISPOSAL PIT) TO A DEPTH OF 8 INCHES
4. FERTILIZE SEED AND MULCH ALL THE NEUTRALIZED AREAS AND ALL OTHER DISTURBED AREAS (0.8 ACRES)

ADDITIONAL INFORMATION PERTAINING TO THIS SITE MAY EXIST IN THE DEPARTMENT OF STATE LANDS' FILES OR AT SPECTRUM ENGINEERING'S OFFICE. THIS MATERIAL IS AVAILABLE FOR REVIEW BY ANY INTERESTED PARTY.

- LEGEND**
- 3220 — CONTOUR
 - COAL SLACK
 - - - DRAINAGE
 - ① PICTURE NUMBER AND ORIENTATION



Topography Prepared From Hasselblad Camera, 50 MM. Distagon Lens, Aerial Photography, 1"=800'. This Topography is of Reconnaissance Class And Has Not Been Field Checked Associated Surveys, Inc., Billings, Montana.

CONSTRUCTION PHOTOS

ARCHAEOLOGICAL NOTICE

ANY KNOWN ARCHAEOLOGICAL MATERIALS NEAR THE CONSTRUCTION AREAS WILL BE MARKED BY THE OWNER. AT NO TIME SHALL THESE ARCHAEOLOGICAL MATERIALS BE DISTURBED WITHOUT THE WRITTEN PERMISSION FROM THE OWNER.

REDUCED PRINTS ARE APPROX.
1/5 ORIGINAL SCALE

HAZARD NOTICE

MANY POTENTIAL HAZARDS EXIST AT THIS SITE. THE EXTENT OF THESE HAZARDS IS NOT FULLY KNOWN.

THE CONTRACTOR, SUBCONTRACTORS, AND THEIR EMPLOYEES WILL COMPLY WITH ALL APPLICABLE LOCAL, STATE, AND FEDERAL SAFETY REGULATIONS IN THE PERFORMANCE OF THE REQUIRED WORK. CONTRACTORS AND OTHER PERSONS WORKING AT THE SITES SHALL BE FULLY RESPONSIBLE FOR APPRISING THEMSELVES OF ANY HAZARDOUS CONDITIONS WHICH MAY EXIST AND SHALL TAKE WHATEVER STEPS ARE NECESSARY TO INSURE THEIR SAFETY AND THE SAFETY OF OTHERS WHILE PERFORMING THEIR DUTIES.

LANDOWNER

ALAN CHURCHILL
1219 2nd EAST
ROUNDUP, MT 59072
PHONE: (406) 323-1180 (HOME)
(406) 323-2403 (WORK)

SITE PLAN AND GENERAL LAYOUT

KLEIN REVEGETATION SITE
SECTION 36, T8N, R25E
MUSSELHELL COUNTY, MONTANA

STATE OF MONTANA
DEPARTMENT OF STATE LANDS
ABANDONED MINE RECLAMATION BUREAU, RECLAMATION DIVISION

DATE: July 1993
DRAWN BY: DLO
CHECKED BY:
APPROVED BY: WCM
NO. DATE BY:

SPECTRUM ENGINEERING
Mining and Civil Engineers
1413 4th AVE NORTH
BILLINGS MONTANA

SHEET NO. 7 of 9

**AS-BUILT DRAWING
AND PHOTO INDEX**



① Picture 1 is a close-up of the adit opening looking east.



② Picture 2 shows the topography and entrance of the opening from a helicopter view looking east.

HAZARD NOTICE

MANY POTENTIAL HAZARDS EXIST AT THIS SITE. THE EXTENT OF THESE HAZARDS IS NOT FULLY KNOWN.

THE CONTRACTOR, SUBCONTRACTORS, AND THEIR EMPLOYEES WILL COMPLY WITH ALL APPLICABLE LOCAL, STATE, AND FEDERAL SAFETY REGULATIONS IN THE PERFORMANCE OF THE REQUIRED WORK. CONTRACTORS AND OTHER PERSONS WORKING AT THE SITES SHALL BE FULLY RESPONSIBLE FOR APPRISING THEMSELVES OF ANY HAZARDOUS CONDITIONS WHICH MAY EXIST AND SHALL TAKE WHATEVER STEPS ARE NECESSARY TO INSURE THEIR SAFETY AND THE SAFETY OF OTHERS WHILE PERFORMING THEIR DUTIES.

STORM WATER POLLUTION PREVENTION AND EROSION CONTROL PLAN BEST MANAGEMENT PRACTICES FOR STORM WATER CONTROL

The Owner is the Department of State Lands, Reclamation Division, Abandoned Mine Reclamation Bureau, 1625 11th Avenue, Helena, Montana 59620 at telephone 1-444-2074. The project manager is Joel Chavez.

The construction activity is described in the Coal Maintenance Work Description. The reclamation construction is estimated to disturb and reclaim 0.01 acres during this project. This site is located in the NW¼NW¼ of Sec. 36 T4S, R22E, Carbon County.

The estimated time period will be ½ day from the start of on-site reclamation construction until the site is permanently fertilized, seeded and mulched (long term erosion controls are installed). This is the time from site arrival until demobilization (weather dependant).

This site is located approximately 1500' from Elbow Creek which flows into the Clarks Fork of the Yellowstone which flows into the Yellowstone River.

Best Management Practices (BMP's) during construction to control sediment and erosion in storm runoff: Temporary stabilization practices - mulching entire area to be revegetated; and Permanent stabilization practices - seeding and fertilizing (100% revegetation of the site).

Good housekeeping for petroleum products, wastes, fertilizer and off-site tracking will be followed by the Contractor as outlined by the MPDES Storm Water discharge permit erosion control plan.

ADDITIONAL INFORMATION PERTAINING TO THESE SITES MAY EXIST IN THE DEPARTMENT OF STATE LANDS' FILES OR AT SPECTRUM ENGINEERING'S OFFICE. THIS MATERIAL IS AVAILABLE FOR REVIEW BY ANY INTERESTED PARTY.



COAL MAINTENANCE

1. Salvage 1' of cover soil from the borrow area (estimate 3 cubic yards).
2. Excavate adit opening to allow backfilling and stockpile material (estimate 1.5 cubic yards).
3. Backfill adit with borrow material and stockpiled material from excavation of adit opening (estimate 5 cubic yards plus 1.5 cubic yards from excavation step).
4. Place 1' of cover soil over backfilled subsidence and sealed adit.
5. Fertilize, seed and mulch all disturbed areas (estimate 0.01 acres).




ARCHAEOLOGICAL NOTICE

ANY KNOWN ARCHAEOLOGICAL MATERIALS NEAR THE CONSTRUCTION AREAS WILL BE MARKED BY THE OWNER. AT NO TIME SHALL THESE ARCHAEOLOGICAL MATERIALS BE DISTURBED WITHOUT THE WRITTEN PERMISSION FROM THE OWNER.

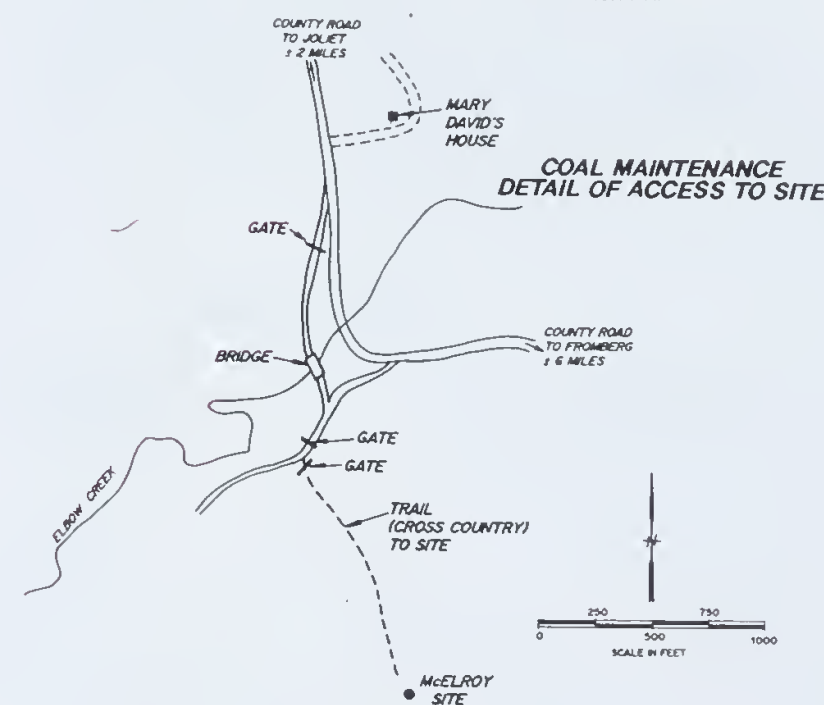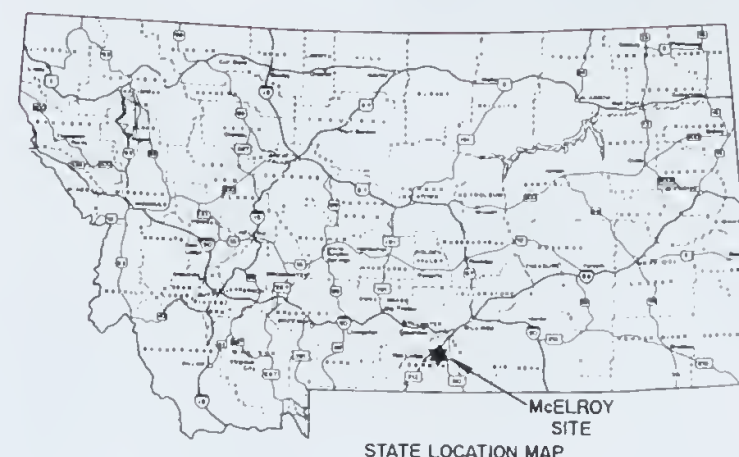

COAL MAINTENANCE CROSS SECTION OF OPEN ADIT

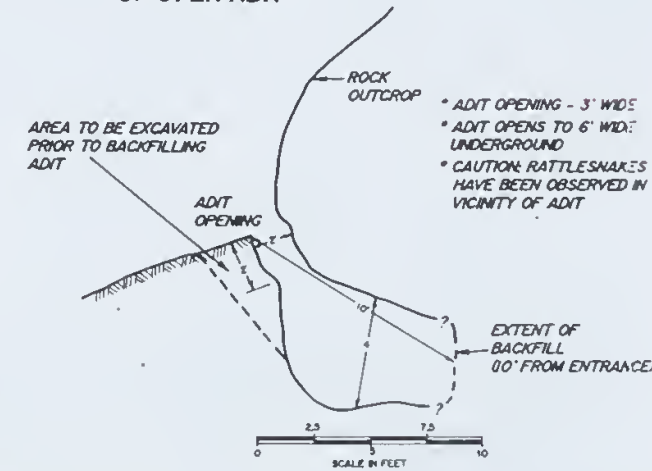

LANDOWNER/CONTACT

STATE OF MONTANA (ALL OF SEC. 36)
C/O DEPT. OF STATE LANDS
JEFF HAGENER, CHIEF
SURFACE MANAGEMENT BUREAU
LAND ADMINISTRATION DIVISION
1625 11TH AVENUE
HELENA, MT 59620
PHONE: (406) 444-2074

ACCESS OWNER AND LESSEE

LESSEE FOR ALL OF SECTION 36 AND
OWNER OF ACCESS ROUTE IN SECTION 25

MRS. MARY DAVID
P.O. BOX 215
JOLIET, MT 59041
PHONE: (406) 962-3433

REDUCED PRINTS ARE APPROX.
½ ORIGINAL SCALE


Topography Based On USGS 7½' Quadrangle:
FROMBERG, MT. This Topography Is Of Reconnaissance
Class And Has Not Been Field Checked



VICINITY ACCESS MAP

BLM MAP - PRIYOR 36

R 22 E

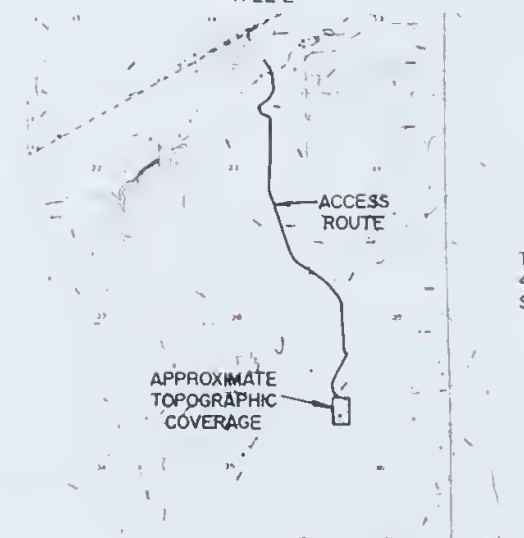

SITE LOCATION MAP

FROMBERG, MT 7 1/2' USGS QUAD

SITE PLAN AND GENERAL LAYOUT

McELROY SITE
SECTION 36, T4S, R22E
CARBON COUNTY, MONTANA

STATE OF MONTANA
DEPARTMENT OF STATE LANDS
ABANDONED MINE RECLAMATION BUREAU, RECLAMATION DIVISION

SPECTRUM ENGINEERING
Mining and Civil Engineers

1413 4TH AVE NORTH
BILLINGS, MONTANA

DATE June, 1993
DRAWN BY RMS
APPROVED BY
REVISIONS
DATE BY
SHEET NO 8 of 9

AS-BUILT DRAWING AND PHOTO INDEX

COAL MAINTENANCE



⑦ Picture 1 is a helicopter view of air shaft and failed grate looking to the south.

1. Remove and salvage steel grata from Shaft #1.
2. Backfill Shaft #1 (12'x18'x26' daap) with material from Waste Dump #4.
3. Replace salvaged steel grata over backfilled Shaft #1 after shaft is backfilled flush with ground surface.
4. After placement of grata, rebuild slopa west of and adjacent to shaft using material from Waste Dump #4. Rebuild slopa to bland with surrounding topography approximately 10' to the south and continua to 20' north of Shaft #1 (estimate 175 cubic yards).
5. Excavate a runoff diversion ditch on the north and the south end of the rebuilt slopa as shown.
6. Revegetate - broadcast seed and fertilize.
7. Place straw bales for erosion control at the toe of the rebuilt slopa.

AS-BUILT

2. Backfill quantity = 562.5cy.
6. Revegetated 0.42 acres.

STORM WATER POLLUTION PREVENTION AND EROSION CONTROL PLAN BEST MANAGEMENT PRACTICES FOR STORM WATER CONTROL

The Owner is the Department of State Lands, Reclamation Division, Abandoned Mine Reclamation Bureau, 1625 11th Avenue, Helena, Montana 59620 at telephone 1-444-2074. The project manager is Joel Chavez


The construction activity is described in the Maintenance Work Description. The reclamation construction is estimated to disturb and reclaim 0.22 acres during this project. This site is located in the NE¼NE¼ of Sec. 8, T9S, R27E, Carbon County

The estimated time period will be four days from the start of on-site reclamation construction. This is the time from site arrival until demobilization (weather dependant)

This site is located approximately 1½ miles from Crooked Creek. This site is extremely dry and very little background vegetation exists. The waste dump that will be used to backfill the shaft and rebuild the slope adjacent to the shaft is comprised predominantly of rock. There is currently no topsoil over the waste dump and there is no topsoil on or near the site to promote revegetation. However, revegetation efforts will be attempted for this site. Best Management Practices (BMP's) during construction to control sediment and erosion in storm runoff. Temporary stabilization practices - placing straw bales for erosion control; and Permanent stabilization practices - seeding and fertilizing (100% revegetation of the site).

Good housekeeping for petroleum products, wastes, fertilizer and off site tracking will be followed by the contractor as outlined by the MPDES Storm Water discharge permit erosion control plan

COAL MAINTENANCE CROSS SECTION OF SHAFT #1 AND SLOPE TO BE REBUILT

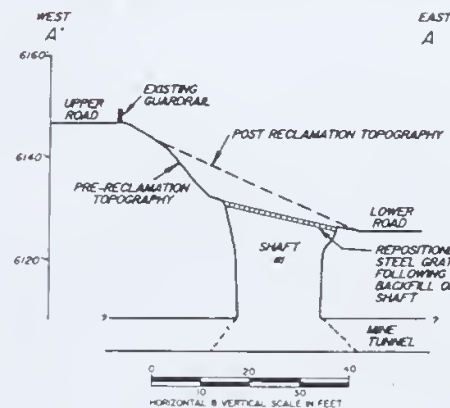

REDUCED PRINTS ARE APPROX.
½ ORIGINAL SCALE

ARCHAEOLOGICAL NOTICE

ANY KNOWN ARCHAEOLOGICAL MATERIALS NEAR THE CONSTRUCTION AREAS WILL BE MARKED BY THE OWNER. AT NO TIME SHALL THESE ARCHAEOLOGICAL MATERIALS BE DISTURBED WITHOUT THE WRITTEN PERMISSION FROM THE OWNER.

NOTES TO CONTRACTOR

1. Claim corner markers are not to be disturbed
2. Prior to construction, all drillholes will be staked and flagged by the Department's Representative and are not to be disturbed

INSTALL OWNER PROVIDED SIGN

LEGEND

- 6090 — CONTOUR
- WASTE DUMP
- - - DRAINAGE
- ⑦ PICTURE NUMBER AND ORIENTATION
- - - UNDERGROUND MINE WORKINGS
- OPEN ADIT

CONSTRUCTION PHOTOS

LANDOWNER AND CONTACT

KEN HANIFY
BUREAU OF LAND MANAGEMENT
BILLINGS RESOURCE AREA
810 E. MAIN
BILLINGS, MT 59105
PHONE (406) 657-6262

MINERAL CLAIMANT

JAMES J. STOICK
1600 AVENUE E
BILLINGS, MT 59102
PHONE (406) 252-1438

NOTICE

AN ABANDONED MINE UNDERLIES THIS SITE. MANY POTENTIAL HAZARDS EXIST. THE EXTENT OF THESE HAZARDS IS NOT FULLY KNOWN. CONTRACTORS AND OTHER PERSONS WORKING AT THE SITE SHALL APPRISE THEMSELVES OF THE CONDITIONS AND TAKE WHATEVER STEPS ARE DEEMED NECESSARY TO INSURE SAFETY WHILE PERFORMING THEIR DUTIES.

HARDROCK MAINTENANCE

DANDY WEST UPPER SITE

SECTION 8, T9S, R27E
CARBON COUNTY, MONTANA

DATE: April 1993
SHEET NO. 9 of 9
SPECTRUM ENGINEERING
Mining and Civil Engineers
Billings, Montana

SITE PLAN AND GENERAL LAYOUT

DANDY WEST UPPER SITE
SECTIONS 8 & 9, T9S, R27E
CARBON COUNTY, MONTANA


STATE OF MONTANA
DEPARTMENT OF STATE LANDS
ABANDONED MINE RECLAMATION BUREAU, RECLAMATION DIVISION

DATE: October 1988
DRAWN BY: OLO
CHECKED BY:
APPROVED BY:
REVISIONS
DATE: 3/21/88 BY: J.R.J.

SPECTRUM ENGINEERING
Mining and Civil Engineers
1413 4th AVE NORTH
BILLINGS, MONTANA

SHEET NO. 1 of 1

AS-BUILT DRAWING AND PHOTO INDEX

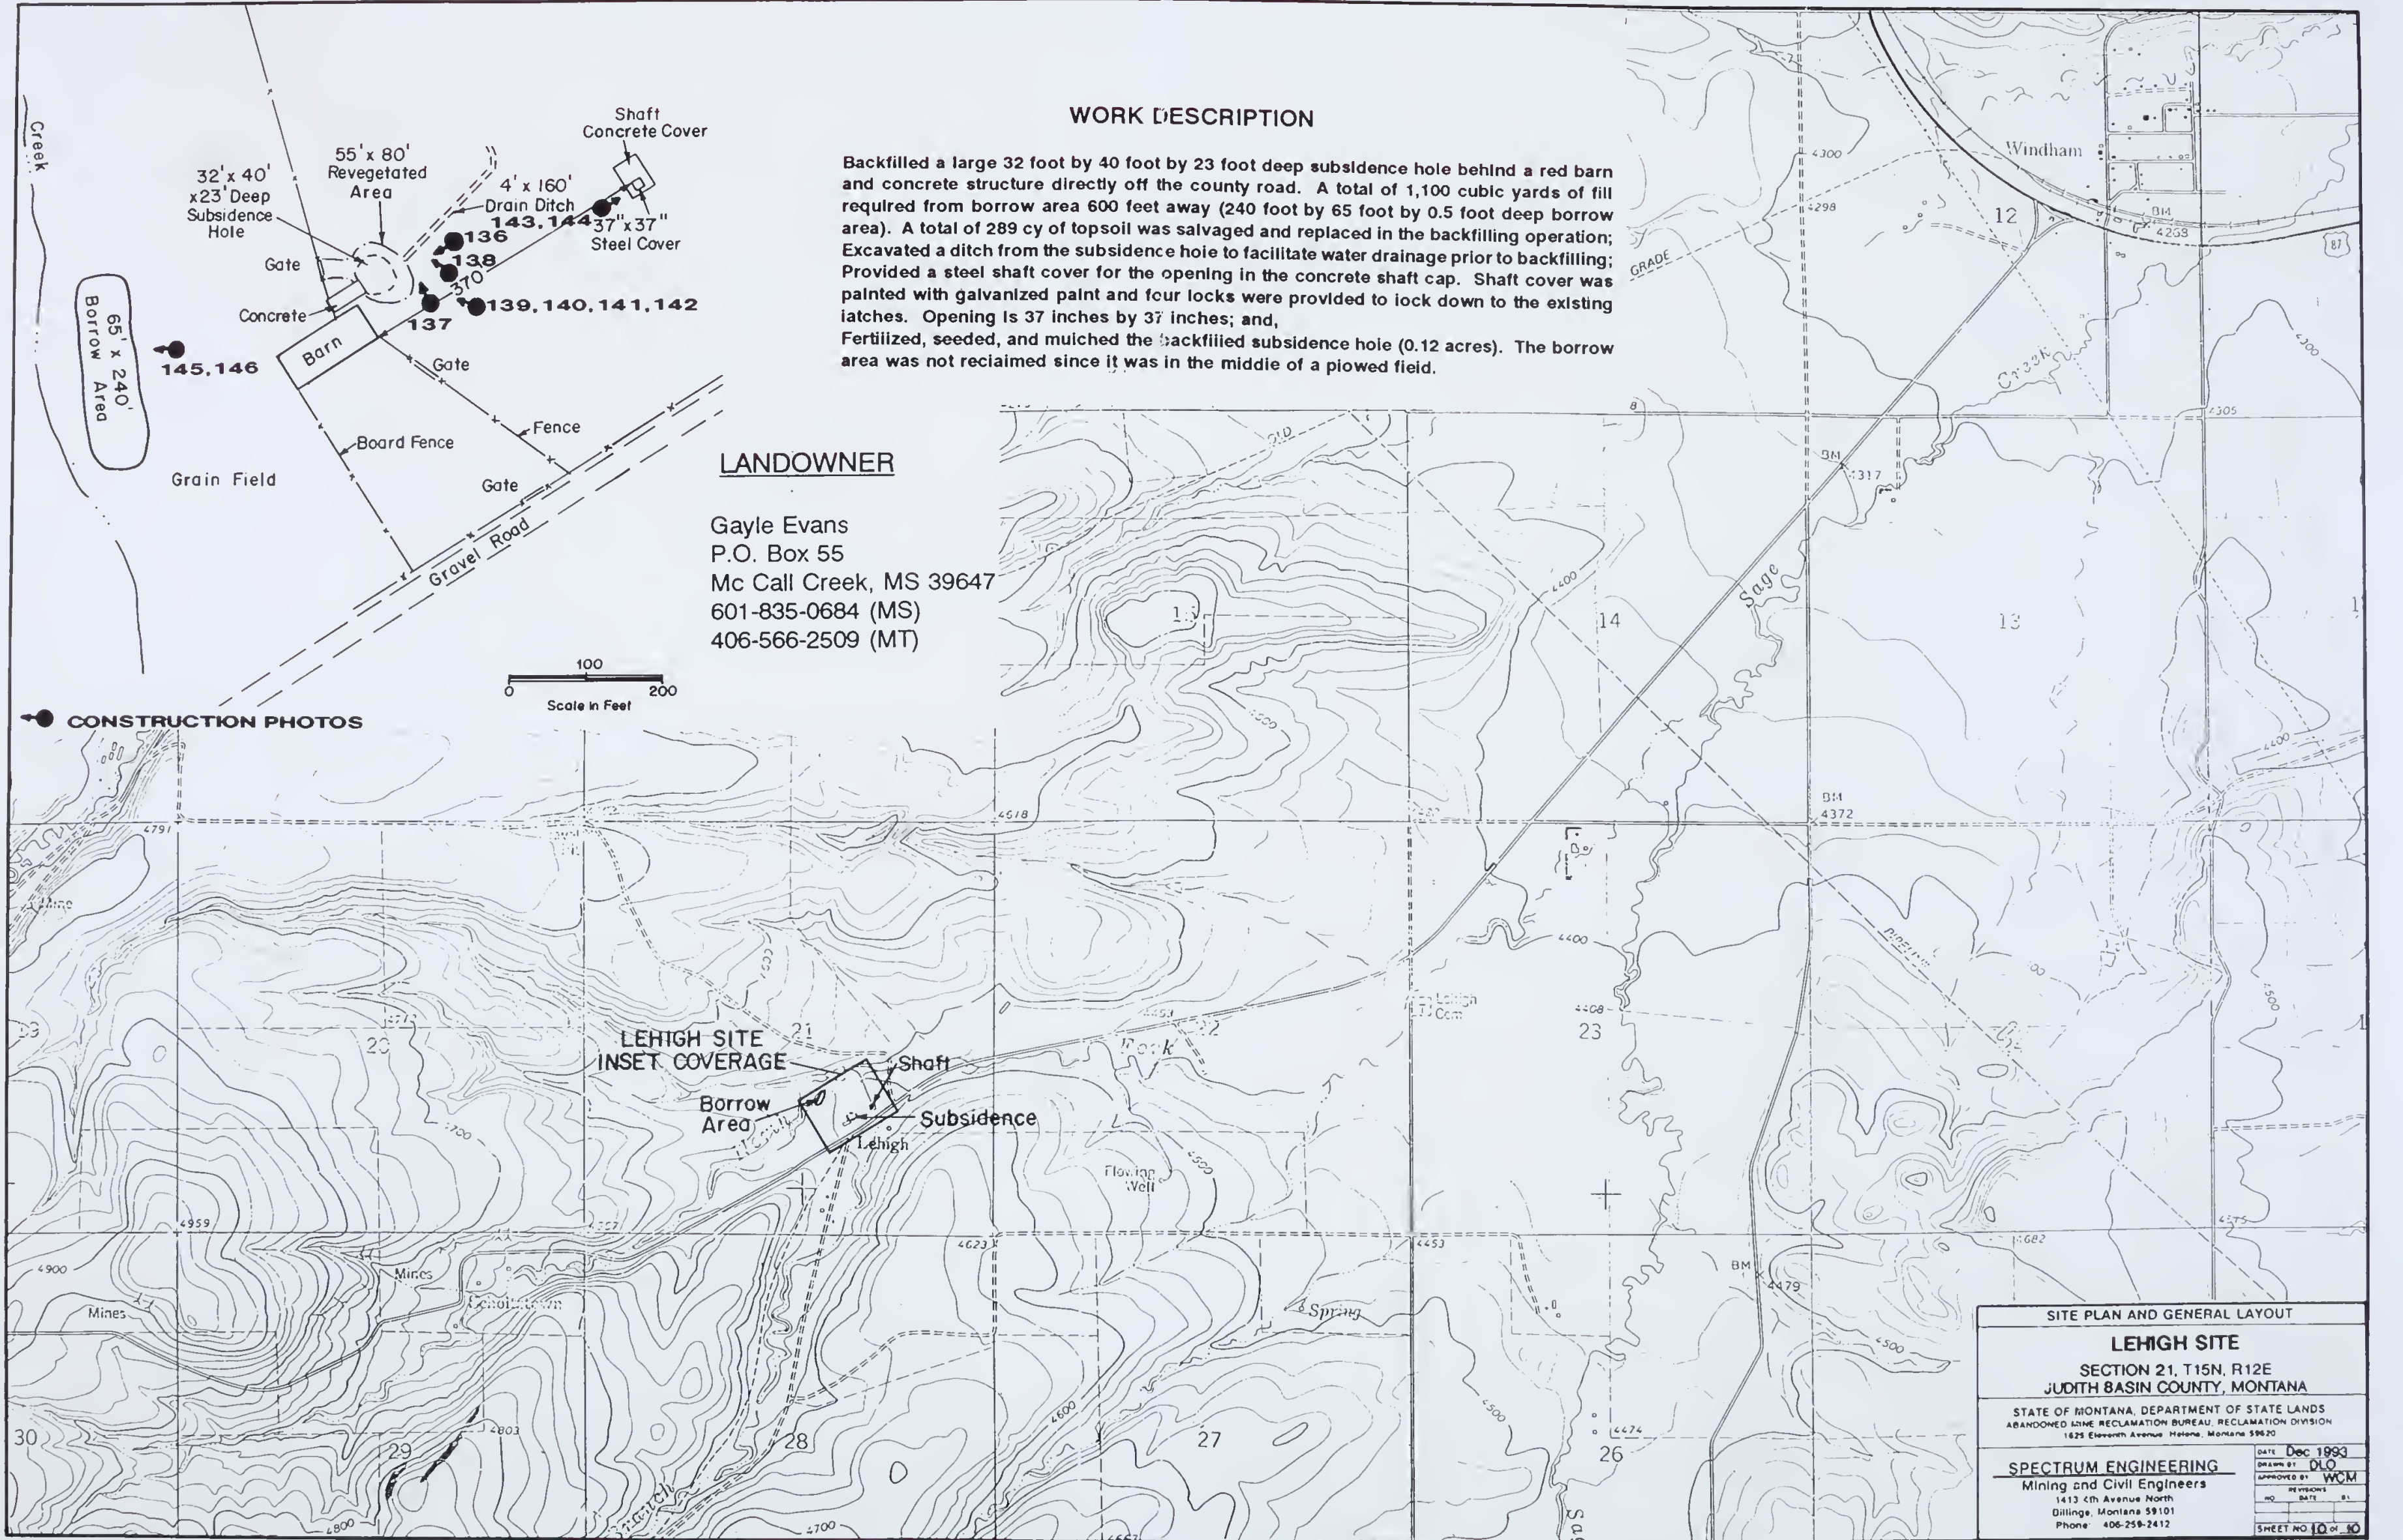

WORK DESCRIPTION

Backfilled a large 32 foot by 40 foot by 23 foot deep subsidence hole behind a red barn and concrete structure directly off the county road. A total of 1,100 cubic yards of fill required from borrow area 600 feet away (240 foot by 65 foot by 0.5 foot deep borrow area). A total of 289 cy of topsoil was salvaged and replaced in the backfilling operation; Excavated a ditch from the subsidence hole to facilitate water drainage prior to backfilling; Provided a steel shaft cover for the opening in the concrete shaft cap. Shaft cover was painted with galvanized paint and four locks were provided to lock down to the existing latches. Opening is 37 inches by 37 inches; and, Fertilized, seeded, and mulched the backfilled subsidence hole (0.12 acres). The borrow area was not reclaimed since it was in the middle of a plowed field.

LANDOWNER

Gayle Evans
P.O. Box 55
Mc Call Creek, MS 39647
601-835-0684 (MS)
406-566-2509 (MT)

CONSTRUCTION PHOTOS

| | |
|--|--|
| SITE PLAN AND GENERAL LAYOUT | |
| LEHIGH SITE | |
| SECTION 21, T15N, R12E JUDITH BASIN COUNTY, MONTANA | |
| STATE OF MONTANA, DEPARTMENT OF STATE LANDS ABANDONED LIME RECLAMATION BUREAU, RECLAMATION DIVISION 1625 Eleventh Avenue Helena, Montana 59620 | |
| SPECTRUM ENGINEERING Mining and Civil Engineers 1413 4th Avenue North Billings, Montana 59101 Phone: 406-259-2412 | |
| DATE: Dec 1993 DRAWN BY: DLO APPROVED BY: WCM REVISIONS: 01 SHEET NO: 10 of 10 | |

1993 SOUTHEASTERN MT MAINTENANCE PROJECT PHOTO DESCRIPTIONS

| <u>ED R</u> | <u>DATE TAKEN</u> | <u>SUBJECT OR COMMENTS</u> |
|-----------------|-----------------------|---|
| | 09-21-93 | Pre-construction view of adit subsidence. |
| | 09-21-93 | Pre-construction of adit subsidence. |
| | 09-21-93 | Pre-construction of adit opening. |
| | 09-21-93 | Excavating opening to facilitate backfilling. |
| | 09-21-93 | Hole backfilled, topsoiled and seeded. |
| | 09-21-93 | Preparing unvegetated area for seeding. |
| | 09-21-93 | Seeding unvegetated area. |
| | 09-21-93 | Unvegetated area mulched. |
| | 09-21-93 | Unvegetated area mulched. |
| | 09-21-93 | Unvegetated area mulched. |

CREEK

| | |
|----------|--------------------------------------|
| 09-20-93 | View of erosion channels. |
| 09-20-93 | Close up of channels. |
| 09-20-93 | Pre-construction view of subsidence. |
| 09-20-93 | Pre-construction view of subsidence. |

1993 SOUTHEASTERN MT MAINTENANCE PROJECT PHOTO DESCRIPTIONS

| ED R | DATE TAKEN | <u>SUBJECT OR COMMENTS</u> |
|----------|---------------|---|
| ROCK | | |
| | 09-21-93 | Preconstruction view of erosion channels. |
| | 09-21-93 | Regrading erosion channels. |
| | 09-21-93 | Regrading complete. |
| | 09-21-93 | Crimping mulch on erosion area. |
| | 09-21-93 | Straw bales after placement. |
| | 09-21-93 | Staking straw bales in place. |
| | 01-25-93 | Pre-construction view of 2 very small subsidence holes. |
| | 09-21-93 | Excavating the enlarged subsidence hole. |
| | 09-21-93 | Backfilling subsidence hole. |
| | 09-21-93 | Crimping mulch over subsidence area. |
| | 09-21-93 | Crimping mulch over subsidence area. |
| ANDERSON | | |
| | 03-30-93 | Pre-construction view of subsidence hole. |
| | 09-22-93 | Subsidence hole excavated. |
| | 09-22-93 | Applying mulch after backfilling completed. |

1993 SOUTHEASTERN MT MAINTENANCE PROJECT PHOTO DESCRIPTIONS

| ED R | DATE TAKEN | <u>SUBJECT OR COMMENTS</u> |
|---------|---------------|---|
| ROCK | | |
| | 09-21-93 | Preconstruction view of erosion channels. |
| | 09-21-93 | Regrading erosion channels. |
| | 09-21-93 | Regrading complete. |
| | 09-21-93 | Crimping mulch on erosion area. |
| | 09-21-93 | Straw bales after placement. |
| | 09-21-93 | Staking straw bales in place. |
| | 01-25-93 | Pre-construction view of 2 very small subsidence holes. |
| | 09-21-93 | Excavating the enlarged subsidence hole. |
| | 09-21-93 | Backfilling subsidence hole. |
| | 09-21-93 | Crimping mulch over subsidence area. |
| | 09-21-93 | Crimping mulch over subsidence area. |
| NDERSON | | |
| | 03-30-93 | Pre-construction view of subsidence hole. |
| | 09-22-93 | Subsidence hole excavated. |
| | 09-22-93 | Applying mulch after backfilling completed. |

1993 SOUTHEASTERN MT MAINTENANCE PROJECT PHOTO DESCRIPTIONS

| <u>D R</u> | <u>DATE TAKEN</u> | <u>SUBJECT OR COMMENTS</u> |
|----------------|-----------------------|---|
| (CONT.) | | |
| | 09-30-93 | Pre-construction looking south at Coal Slack Pile #1. |
| | 10-15-93 | Liming Coal Slack Pile #1. |
| | 10-15-93 | Revegetating Coal Slack Pile #1. |
| | 10-15-93 | Revegetating Coal Slack Pile #1. |
| | 09-30-93 | Pre-construction looking southeast at Coal Slack Pile #2. |
| | 10-01-93 | Roadway with #2 pile to the left. |
| | 10-01-93 | View of #2 Slack Pile after slack removal. |
| | 10-15-93 | View of #2 Slack Pile with topsoil in place. |
| | 10-04-93 | View of #2 Slack Pile ready for lime. |
| | 10-26-93 | View of #2 Slack Pile after mulching. |
| | 10-26-93 | View of #2 Slack Pile being crimped. |
| | 09-30-93 | Pre-construction looking west at Slack Pile #3. |
| | 09-30-93 | Pre-construction view of Slack Pile #4 (135 x 12'). |
| | 10-04-93 | Stock Pile #3 being contoured with scraper. |
| | 10-05-93 | Spreading lime on #3 & #4 Slack Piles. |

1993 SOUTHEASTERN MT MAINTENANCE PROJECT PHOTO DESCRIPTIONS

| <u>D R</u> | <u>DATE TAKEN</u> | <u>SUBJECT OR COMMENTS</u> |
|-----------------------|------------------------------|--|
| (CONT.) | | |
| | 10-26-93 | Post-construction view of #5 Pile. |
| | 09-30-93 | Pre-construction of new Slack Pile #6. |
| | 09-30-93 | Pre-construction of new Slack Pile #7. |
| | 10-04-93 | Site #6 work in progress looking east. |
| | 10-15-93 | #6 Slack Pile with topsoil in place. |
| | 10-15-93 | #7 Slack Pile with topsoil in place. |
| | 10-26-93 | Finished view of #6 and #7. |
| | 10-25-93 | Fertilizer and mulch. |
| | 10-25-93 | Mulching. |
| | 10-14-93 | Klein road edge ready for fertilizer. |
| | 10-27-93 | Roadway finished. |
| | 10-12-93 | Road edge topsoil being hauled. |
| | 10-18-93 | Roadway edge finished. |
| | 09-30-93 | Erosion area upstream (off map) coming down road caused by lack of drainage control when upper coal slack pile revegetated years ago. |

1993 SOUTHEASTERN MT MAINTENANCE PROJECT PHOTO DESCRIPTIONS

| ED R | DATE TAKEN | <u>SUBJECT OR COMMENTS</u> |
|---------|---------------|--|
| (CONT.) | | |
| | 10-14-93 | Zimmerman Pile #1 work in progress. |
| | 10-14-93 | Zimmerman Pile #1 lime spreading. |
| | 10-15-93 | Zimmerman Pile #1 seeding. |
| | 10-15-93 | Zimmerman Pile #1 mulch applied. |
| | 10-18-93 | Zimmerman Pile #1 finished. |
| | 10-06-93 | Pre-construction of Zimmerman Pile #2. |
| | 10-15-93 | Seeding of Zimmerman Pile #2. |
| | 10-15-93 | Zimmerman Pile #2 with mulch applied. |
| | 10-18-93 | Zimmerman Pile #2 completed. |
| | 10-06-93 | Pre-construction of Zimmerman Pile #3. |
| | 10-15-93 | Zimmerman Pile #3 with mulch applied. |
| | 10-06-93 | Pre-construction of Zimmerman Pile #4. |
| | 10-15-93 | Zimmerman Pile #4 with mulch applied. |
| | 10-18-93 | Zimmerman Pile #4 completed. |
| | 10-06-93 | Pre-construction of Zimmerman Pile #5. |

1993 SOUTHEASTERN MT MAINTENANCE PROJECT PHOTO DESCRIPTIONS

| <u>ED R</u> | <u>DATE TAKEN</u> | <u>SUBJECT OR COMMENTS</u> |
|-----------------|-----------------------|--|
| ROY (CONT.) | | |
| | 09-23-93 | Revegetation complete. |
| | 09-23-93 | Revegetation complete. |
| Y WEST UPPER | | |
| | 01-25-93 | Pre-construction of collapsed grate at Dandy West. |
| | 03-30-93 | Pre-construction aerial view of grate at Dandy West. |
| | 09-24-93 | Removing collapsed grate. |
| | 09-24-93 | Removing collapsed grate. |
| | 09-24-93 | Open shaft after ½ of grate is removed. The other half fell into the hole and could not be retrieved. |
| | 09-24-93 | Backfilling in process into shaft. |
| | 09-27-93 | Backfilling side slope. |
| | 09-27-93 | Backfill in place. |
| | 09-28-93 | Seeding. |
| | 09-28-93 | Seeding slope with straw bales in place. |
| | 09-28-93 | Seeding side slope. |

1993 SOUTHEASTERN MT MAINTENANCE PROJECT PHOTO DESCRIPTIONS

| <u>ED R</u> | <u>DATE TAKEN</u> | <u>SUBJECT OR COMMENTS</u> |
|-----------------|-----------------------|---|
| H | | |
| | 12-13-93 | Pre-construction view of subsidence hole. |
| | 12-14-93 | Excavation of drain ditch. |
| | 12-16-93 | Post-construction view of ditch after vegetation. |
| | 12-14-93 | Backfilling subsidence hole with backhoe/loader. |
| | 12-14-93 | Hauling fill material with scraper for subsidence hole. |
| | 12-16-93 | Crimping mulch on mounded fill over subsidence hole. |
| | 12-16-93 | Subsidence hole completed. |
| | 12-13-93 | Pre-construction view of missing shaft cover. |
| | 12-16-93 | New shaft cover in place with new locks. |
| | 12-14-93 | View of stockpiled topsoil and borrow area. |
| | 12-16-93 | Borrow area topsoiled and completed. |
| | 12-14-93 | Dump truck with tilt trailer and pickup. |
| | 12-14-93 | Michigan 110-11 scraper. |
| | 12-14-93 | Case 560 backhoe/loader. |

**BRYAN SITE
T3S, R46E, SEC. 18
POWDER RIVER COUNTY**





4




6



3



5

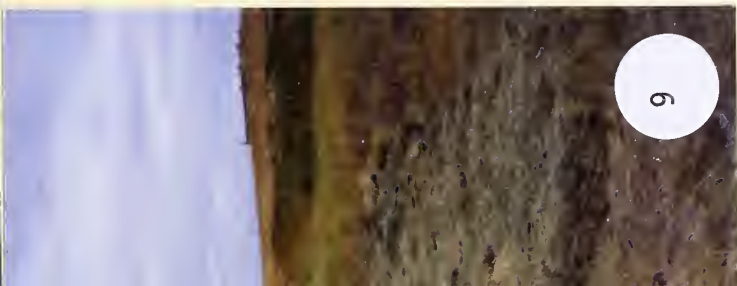

9



10



7



8

**COAL CREEK SITE
T3S, R45E, SEC. 3
POWDER RIVER COUNTY**






15



17

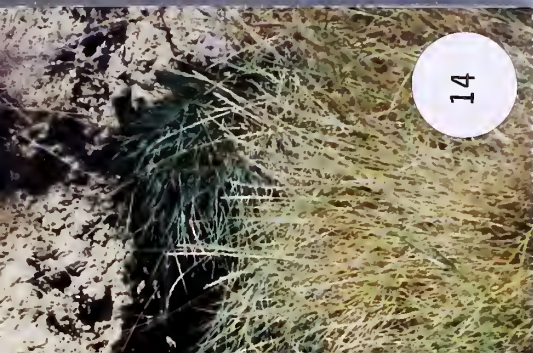

14



16



18



19



20



21

**1993 SOUTHEASTERN MT
MAINTENANCE PROJECT
DSL-AMRB 93-M04**

Before, during and after construction photographs.
Photo descriptions are found in the final report.
Construction period: 9/20/93-10/26/93

23



22



**CROW ROCK SITE
T12N, R45E, SEC. 17
CUSTER COUTNY**






27



28

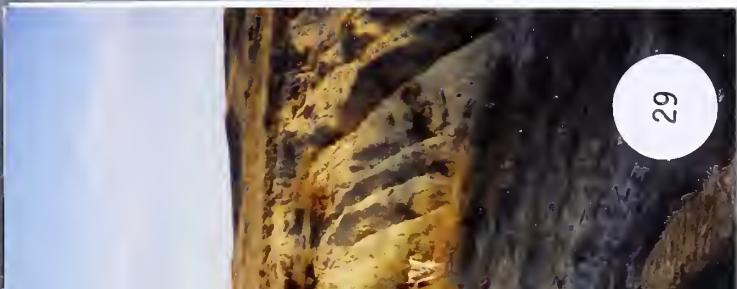

29



30





35



36



37

LEO/ANDERSON
T19N, R38E
SEC. 26, NE $\frac{1}{4}$ NE $\frac{1}{4}$
GARFIELD COUNTY

HELICOPTER TRIP
MARCH 30/31, 1993
JOEL CHAVEZ/
BILL MAEHL



66




38

N SITE
36
JNTY





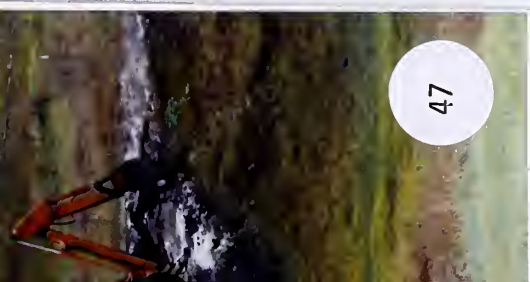

47



48



49



50



51




52



53




54

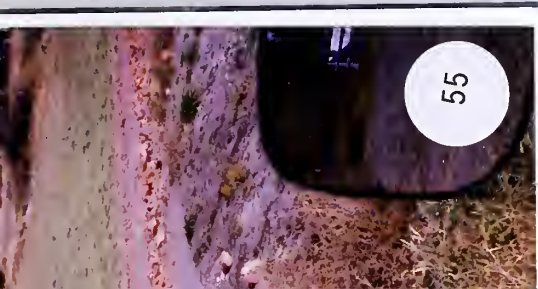

55




56

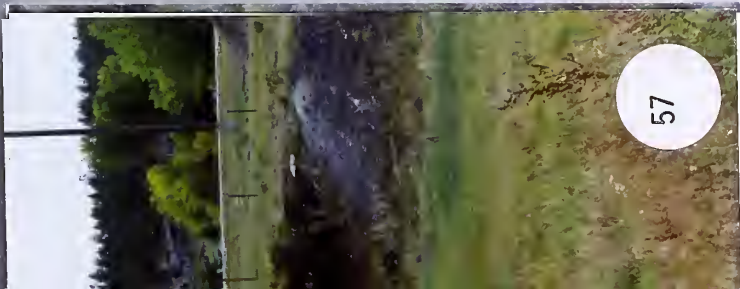

57



58

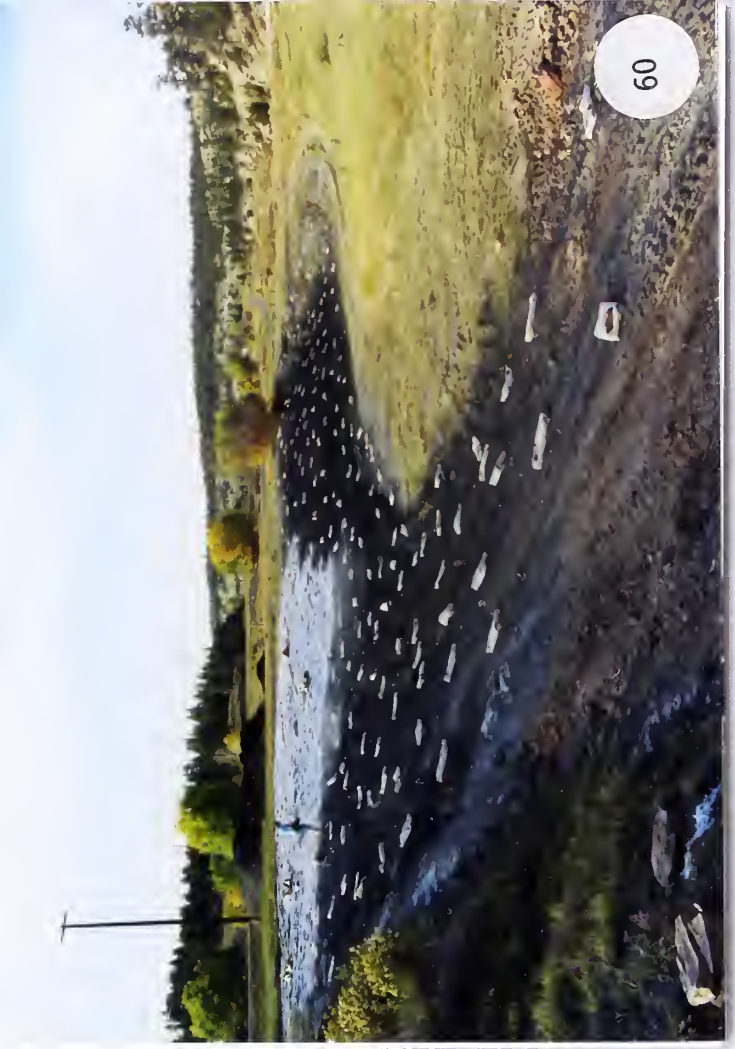



63



64




65



66



67

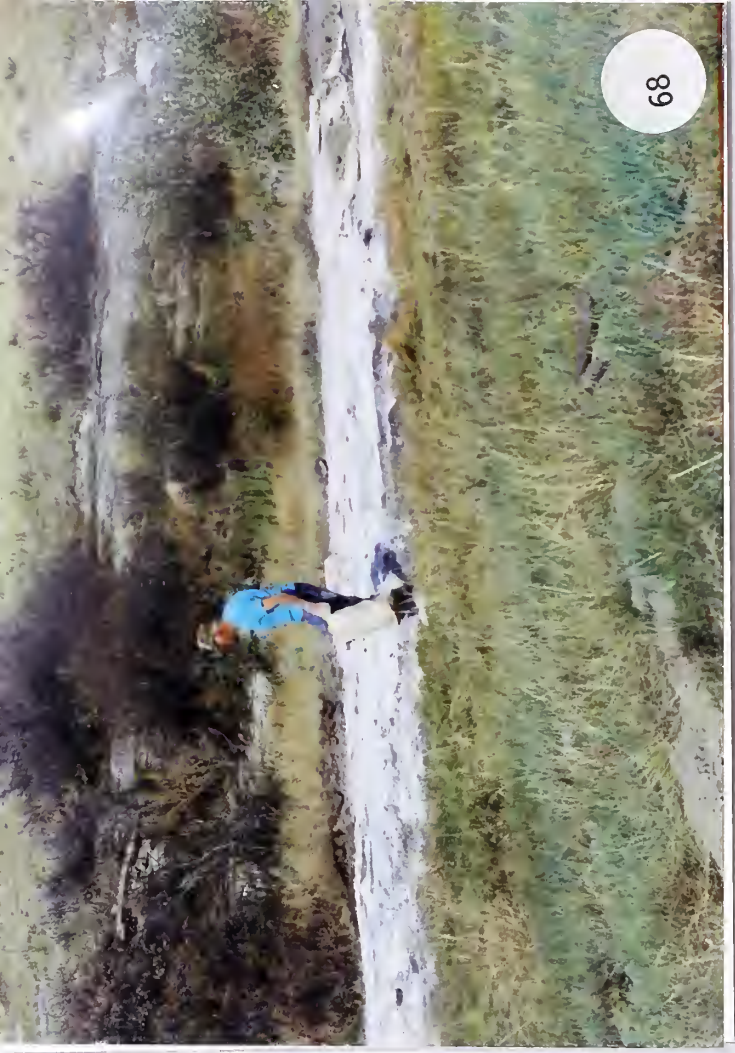

68



69



70



72



74



71



73






79



80

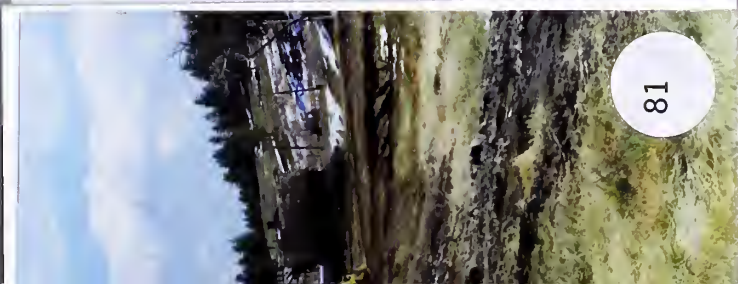

81



82



83



84



85



86



88



90




87



89



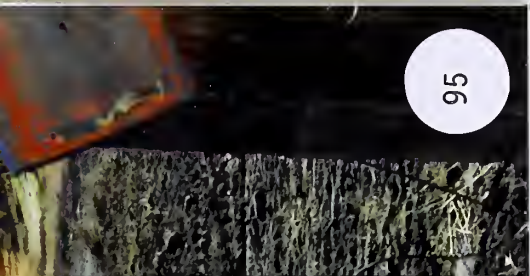

95



96



97



98



99




100



101



102

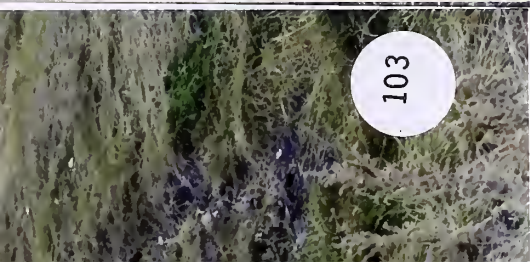

103



104



105



106




107



108



109

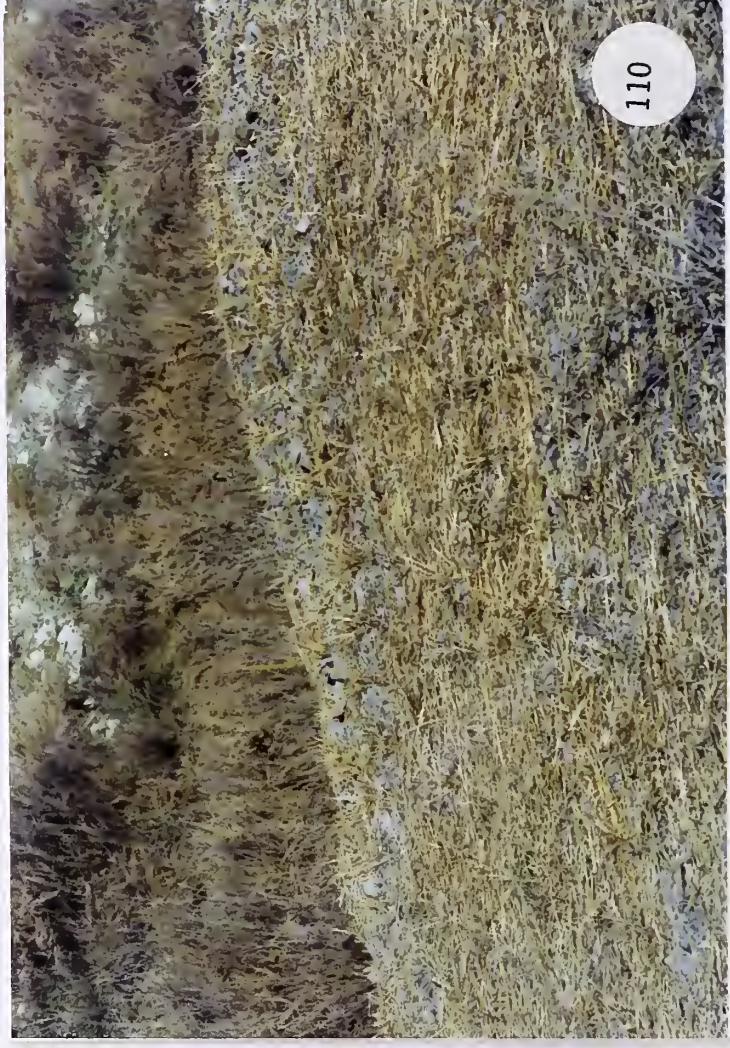

110

**McELROY SITE
T4S, R22E, SEC. 36
CARBON COUNTY**






114



115

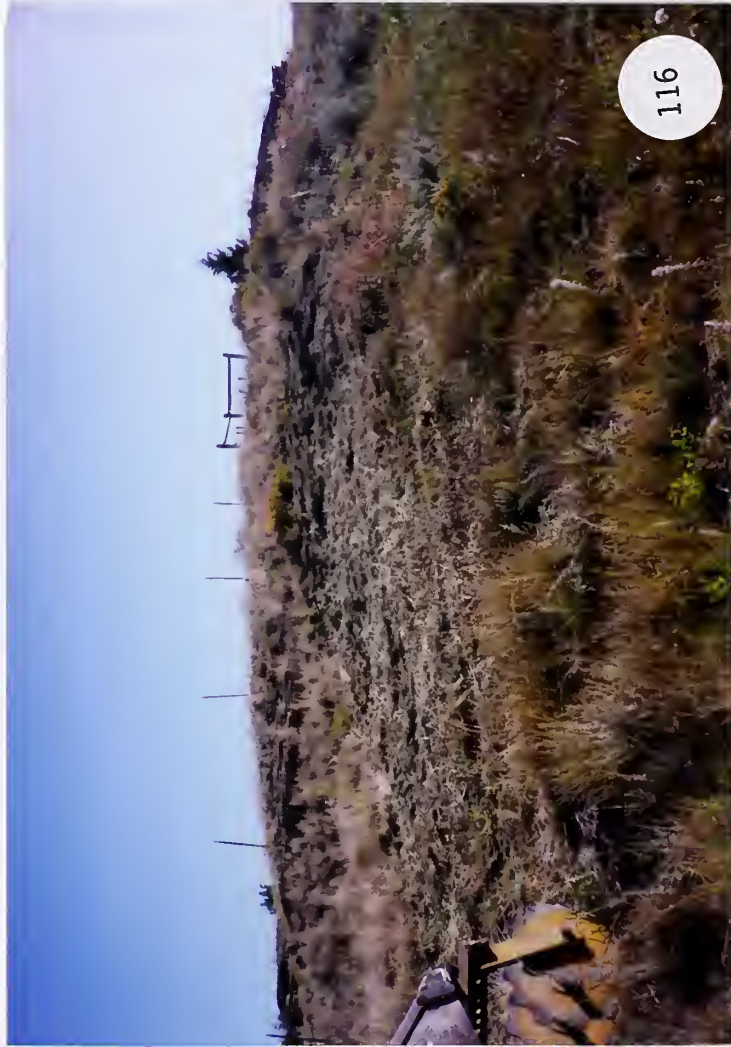

116




117



118



119

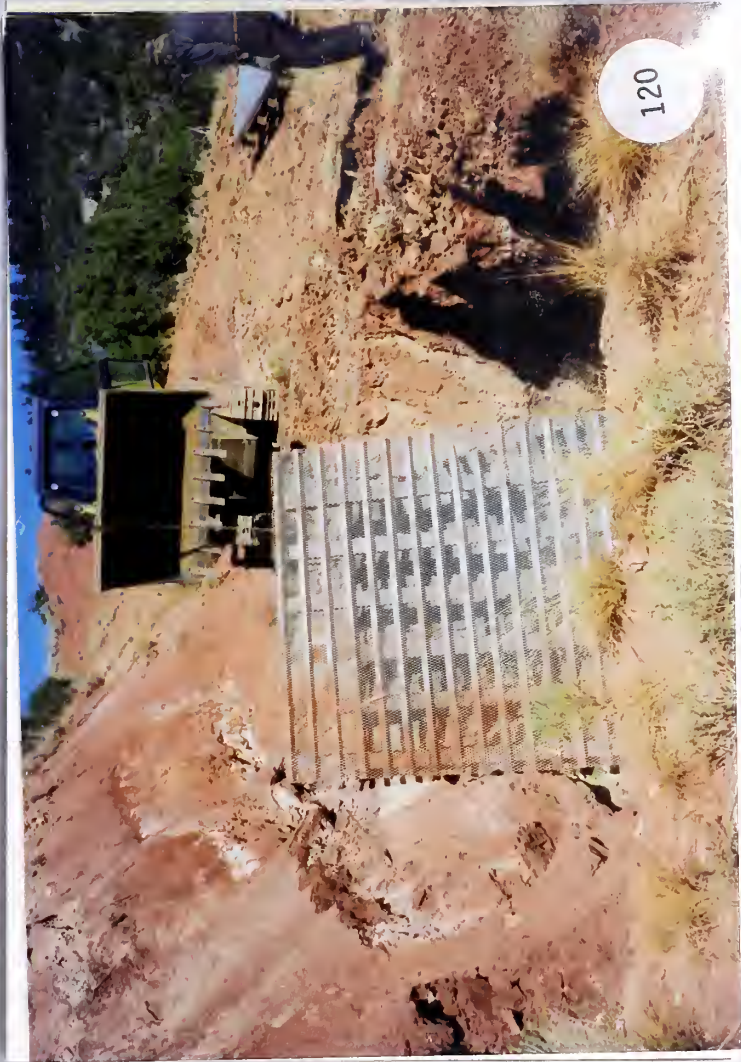

120



122



124



121



123




126




128



125

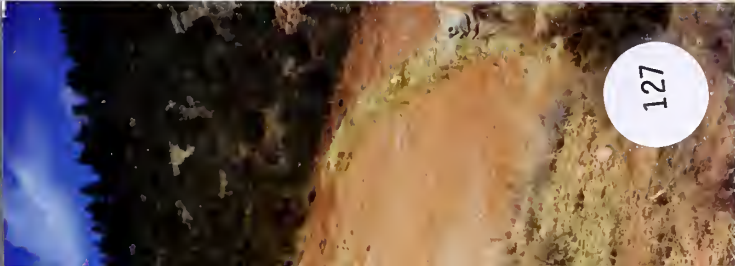

127

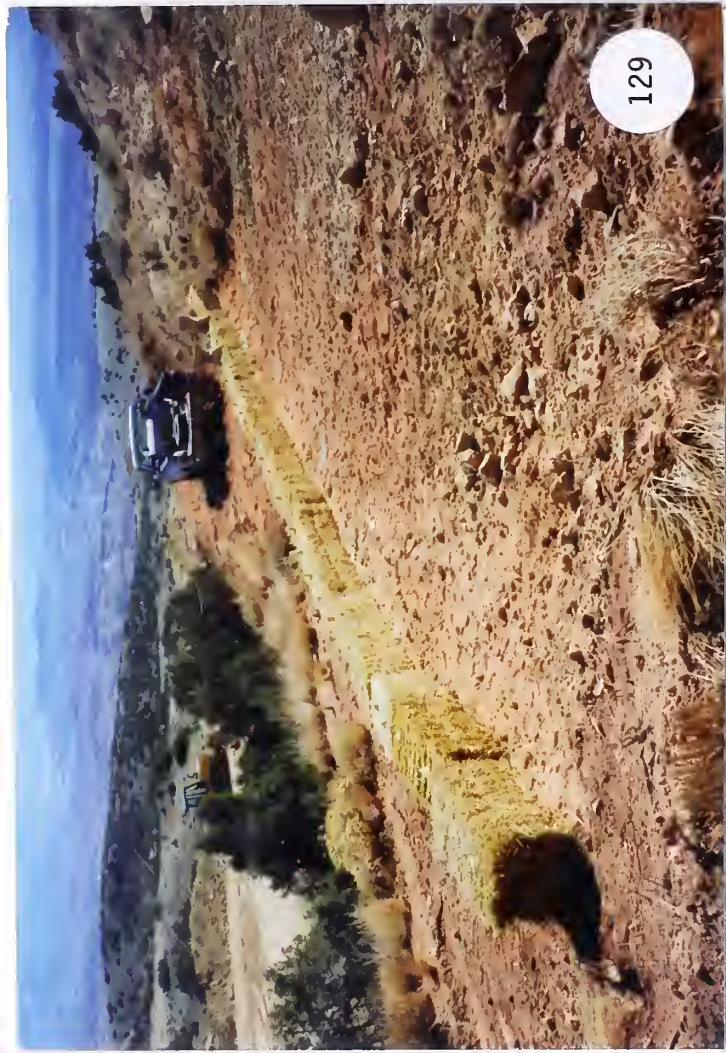


EQUIPMENT





132

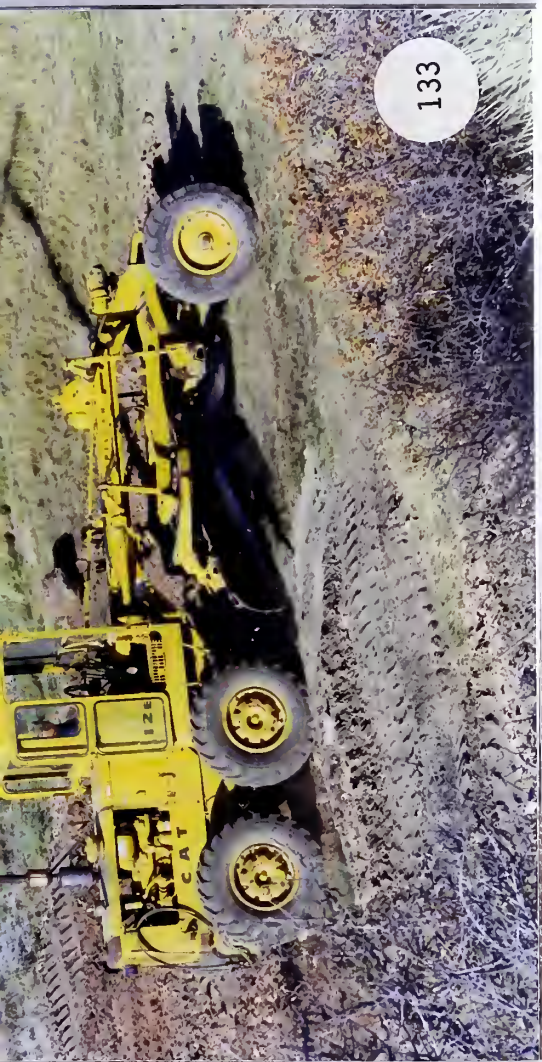

133




134



135

**LEHIGH SITE
T15N, R12E, SEC. 21
JUDITH BASIN COUNTY**



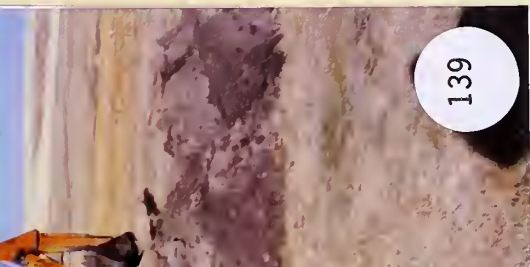

139



140



141



142

**1993 SOUTHEASTERN MT
MAINTENANCE PROJECT
DSL-AMRB 93-M04**

Before, during and after construction photographs of
Lehigh. Photo descriptions are found in the final report.
Construction period: 12/14/93-12/16/93

